

SURVEY & REMONUMENTATION

FEB 25 1999

FILED

SECTION

LAND CORNER RECORDATION CERTIFICATE
Filing Requirement of Act 74, Mich. P.A. 1970

For corners in

Livingston
(County)

Located In:

Corner Code //

1998 OCT 27 P 2: 22

NANCY HAVILAND
 REGISTER OF DEEDS
 LIVINGSTON COUNTY, MI.
 48843

- | | | |
|------------------------------------|-------------------------|-----------|
| 1. Public Land Survey | T <u>1N</u> R <u>6E</u> | <u>15</u> |
| | T _____ R _____ | _____ |
| | T _____ R _____ | _____ |
| | T _____ R _____ | _____ |
| 2. Property Controlling in Section | S _____ T _____ R _____ | _____ |
| | S _____ T _____ R _____ | _____ |
| 3. Miscellaneous Property in Sec. | S _____ T _____ R _____ | _____ |
| | S _____ T _____ R _____ | _____ |

LSC975M

Register of Deeds Stamp & File Number

4. Lot No. _____, Recorded Plat _____
5. Private Claims _____

	A	B	C	D	E	F	G	H	I	J	K	L	M
2	6	5	4	3	2	1							
3													
4	7	8	9	10	11	12							
5													
6	18	17	16	15	14	13							
7													
8	19	20	21	22	23	24							
9													
10	30	29	28	27	26	25							
11													
12	31	32	33	34	35	36							
13													

I, Bryan L. Boss, in a field survey on September 28, 1998, do hereby certify that under requirements of P.A. 74, Michigan P.A. of 1970, the corner points mentioned in lines 1 and 2 above were in conformance with regulations and rules therefore as required in the current manual of survey instructions of the United States Department of the Interior, Bureau of Land Management or by a decree of a Court of Law and/or that the corner points mentioned in lines 3, 4 and 5 above were in conformance with the rules of the Michigan Board of Land Surveyors or by a Decree of a Court of Law; established, re-established, monumented, re-monumented, recovered, found as expressed below:

NOTE: Not more than 4 corners, all in the same town and range, may be recorded on this certificate.

A. Description of original monument and accessories and/or subsequent restoration:

Set post at average distance in marsh


B. Description of corner evidence found and/or method applied in restoring or reestablishing corner:

Found 1/2" iron pipe 40' South of stream

PA. 345 1990, APPROVED BY LIVINGSTON COUNTY
 PEER GROUP ON 9-2-98 CO. REP JED

C. Description of monument for corner and accessories established to perpetuate locating the position of the corner:

Set 1 1/4' by 36" pipe with Brass cap Stamped " Livingston County Monumentation Corner"
 North 53.22 Concrete monument
 S 69 E 18.20 N/T Northside 16" stump
 S 61 E 79.98 N/T Southwest side twin Willow
 S 76 W 31.29 N/T Northside 18" Walnut

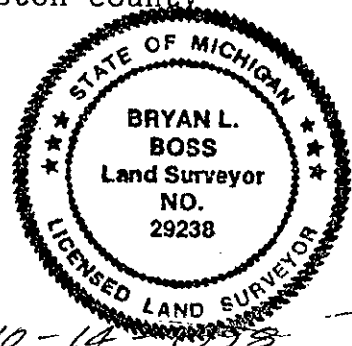

Signed by [Signature]
 Surveyor's Michigan License No. 29238

Date 10-14-1998