

LAND CORNER RECORDATION CERTIFICATE
Filing Requirement of Act 74, Mich. P.A. 1970

For corners in
Livingston

(County)

Located in:

Corner Code L-7

1. Public Land Survey	T <u>1N</u> R <u>6E</u>	<u>L-7</u>
	T <u> </u> R <u> </u>	<u> </u>
	T <u> </u> R <u> </u>	<u> </u>
	T <u> </u> R <u> </u>	<u> </u>
2. Property Controlling In Section	S <u> </u> T <u> </u> R <u> </u>	<u> </u>
	S <u> </u> T <u> </u> R <u> </u>	<u> </u>
3. Miscellaneous Property in Sec.	S <u> </u> T <u> </u> R <u> </u>	<u> </u>
	S <u> </u> T <u> </u> R <u> </u>	<u> </u>

48843
LIVINGSTON COUNTY, MI
REGISTER OF DEEDS
NANCY HAVILLAR

OCT 11 10 28 AM '95

FILED

L.S.C.#479m

Register of Deeds Stamp & File Number

4. Lot No. _____, Recorded Plat _____
5. Private Claims _____

I, Gary R. Boss, in a field survey on 10-4, 1995
do hereby certify that under requirements of P.A. 74, Michigan P.A. of 1970, the corner points mentioned
in lines 1 and 2 above were in conformance with regulations and rules therefore as required in the
current manual of survey instructions of the United States Department of the Interior, Bureau of Land
Management or by a decree of a Court of Law and/or that the corner points mentioned in lines 3, 4 and 5
above were in conformance with the rules of the Michigan Board of Land Surveyors or by a Decree of a
Court of Law; established, re-established, monumented, re-monumented, recovered, found as
expressed below:

NOTE: Not more than 4 corners, all in the same town and range, may be recorded
on this certificate.

A	B	C	D	E	F	G	H	I	J	K	L	M
2	6	5	4	3	2							
3												
4	7	8	9	10	11	12						
5												
6	13	17	16	15	14	13						
7												
8	19	20	21	22	23	24						
9												
10	30	29	28	27	26	25						
11												
12	31	32	33	34	35	36						
13												

A. Description of original monument and accessories and/or subsequent restoration:

White Oak 16" S 14 1/2° 92 links
White Oak 7" N 26° W 66 links
Black Oak 10" S 5 1/4° W 38 links


B. Description of corner evidence found and/or method applied in restoring or reestablishing corner:

Corner has been destroyed by mining operations.
Man-made lake will ultimately cover this location.
Witness monuments will be set 1334.32 feet west;
1328.66 feet east and 1317.71 south of L-7.
1/2" iron 2 feet east of centerline Gravel Pit Road.
N 6° E 313.48' nail & tag west side power pole
N 36° E 380.18' nail & tag southwest side power pole
N 66° E 238.35' nail & tag north side power pole
S 52° E 260.42' nail & tag south side power pole

SURVEY &
REMONUMENTATION

NOV 27 1995

COMMISSION

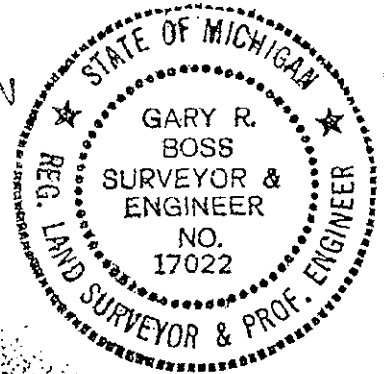

C. Description of monument for corner and accessories established to perpetuate locating the position of the corner:

Witness West

Found bent iron
Set brass cap in 36" pipe at grade level
102.72' N 2° W nail & tag east side 28" Oak
13.43' S 35° E nail & tag northeast side railroad
fence post
16.17' South nail & tag east side 40" Oak
26.58' West nail & tag south side 8" Triple Elm

Witness East

1/2" iron found II
Set 36" iron pipe with brass cap 0.23 feet north on
section line
6.90' N 88° E nail & tag south side fence post
4.27' S 01° E nail & tag west side fence post
96.20' N 15° W nail & tag east side 4" Box Elder

Witness South

Found concrete monument. Set 36" iron pipe with brass cap 0.17 feet east on section line
28.81' N 25° W nail & tag southwest side 8" Cherry
36.35' N 45° E nail & tag southeast side 15" Cherry
74.79' N 40° W nail & tag west side 14" Poplar
34.79' S 10° E nail & tag west side 8" Cherry

Signed by Gary R. Boss Date 10/6/95
Surveyor's Michigan License No. 17022

FORM APPROVED BY MICHIGAN STATE BOARD OF LAND SURVEYORS, JAN. 22, 1971
REVISED MAY 11, 1975
REVISED JAN., 1993

PA. 345 1990, APPROVED BY LIVINGSTON COUNTY
PEER GROUP ON 8-16-95 CO. REP JED

SUMMARY
L-7

North 1/4 Corner, Section 24, T1N-R6E, Green Oak Township, Livingston County, Michigan.

On January 13, 1995, Boss Engineering found 1/4 corner had been destroyed by mining operations. American Aggregate representative informed us that this location would eventually be under a permanent man made lake.

Gary R.. Boss Act 74, submitted on 1-6-94, witnesses L-7 from four power poles 238 feet to 380 feet distant.

Conclusion:

We recommend setting witness monument points 1334.32 feet West, 1328.66 feet East and 1317.71 feet South per calculation sheets and surveys found in this dossier.

GOL-7X