

OCT 26 1995

COMMISSION LAND CORNER RECORDATION CERTIFICATE
Filing Requirement of Act 74, Mich. P.A. 1970

For corners in

Livingston (County)	Located In:	Corner Code #
1. Public Land Survey	T 1N. R 6E	L-9
	T R	
	T R	
	T R	
2. Property Controlling In Section	S T R	
	S T R	
3. Miscellaneous Property in Sec.	S T R	
	S T R	

RECEIVED
OCT 6 11 56 AM '95
NANCY HAVILANE
REGISTER OF DEEDS
LIVINGSTON COUNTY, MI
48023

L.S.C. #468m

Register of Deeds Stamp & File Number

4. Lot No. _____, Recorded Plat _____
5. Private Claims _____

	A	B	C	D	E	F	G	H	I	J	K	L	M
2	6		5		4		3		2		1		
3													
4	7		8		9		10		11		12		
5													
6	15		17		16		15		14		13		
7													
8	19		20		21		22		23		24		
9													
10	30		29		28		27		26		25		
11													
12	31		32		33		34		35		36		
13													

I, Bryan Boss, in a field survey on 9-26, 1995, do hereby certify that under requirements of P.A. 74, Michigan P.A. of 1970, the corner points mentioned in lines 1 and 2 above were in conformance with regulations and rules therefore as required in the current manual of survey instructions of the United States Department of the Interior, Bureau of Land Management or by a decree of a Court of Law and/or that the corner points mentioned in lines 3, 4 and 5 above were in conformance with the rules of the Michigan Board of Land Surveyors or by a Decree of a Court of Law; established, re-established, monumented, re-monumented, recovered, found as expressed below:

NOTE: Not more than 4 corners, all in the same town and range, may be recorded on this certificate.

A. Description of original monument and accessories and/or subsequent restoration:


- White Oak 13" S 69° E 52 links
- Black Oak 6" N 19° W 57 links
- Black Oak 11" S 3 1/2° W 66

B. Description of corner evidence found and/or method applied in restoring or reestablishing corner:

- Multiple Corner-
- 3/4" inch iron pipe found 5 feet South of Centerline Ten Mile Road also found 1/2 inch iron 1.65 feet South of pipe.
- Power pole N 05° W 26.22' to nail
- power pole S 45° E 30.10' to nail
- 12" Box elder S 30° E 28.81' to nail
- 20" Pine S 05° W 25.70' to nail

C. Description of monument for corner and accessories established to perpetuate locating the position of the corner:

- Set brass cap on 1/2" iron in monument box
- 26.25' North nail & tag East side power pole
- 48.11' S 40° W nail & tag Northwest side 15" Pine
- 24.98' South nail & tag East side 20" Pine
- 29.67' S 50° E nail & tag Southwest side Power pole

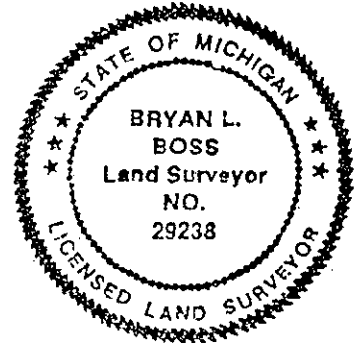

Signed by [Signature] Date OCT 4, 1995
Surveyor's Michigan License No. 29238

SUMMARY
L-9

North 1/4 Corner, Section 25, T1N-R6E, Green Oak Township,
Livingston County, Michigan.

Multiple Corner


Found 3/4" Pipe 0.15 foot below asphalt surface five (5)
feet ± South of centerline of Ten Mile Road. Also found
1/2" iron rod 1.65 feet South of pipe. Iron pipe was set by
Washtenaw Engineering on 6-6-68 (see Page 12). John C.
Miller plat recorded on 12-15-55 does not indicate tie-in
distances.

Witness sheet finds 3 of 4 surveyors utilized Northerly
point. Recorded Plat of "Oakwood Meadows" on 9-29-70 and
recorded plat of "Windcrest" on 3-2-94, concur with
measurement Northerly to center of Section 24, Please note
Multiple corner information on plat of "Windcrest" on Page
23, 24 this dossier.

Conclusion:

We find the Northerly iron (set by Washtenaw Engineering on
6-6-68) should be held and over ride P.K. Nail set by Greg
Ash on 3-1-89.

GOL-9X

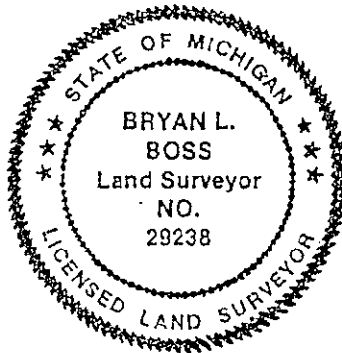

Bryan L. Boss