

FEB 24 1998

SECTION

LAND CORNER RECORDATION CERTIFICATE  
Filing Requirement of Act 74, Mich. P.A. 1970

FILED 9-

For corners in

1997 NOV 25 A 11: 13

LIVINGSTON  
(County)

Located in:  
GREEN OAK TWP.

Corner Code *11*

NANCY HAVILAND  
REGISTER OF DEEDS  
LIVINGSTON COUNTY, MI.  
48843

1. Public Land Survey	T	N	R	6E	M-6
	T		R		
	T		R		
	T		R		
2. Property Controlling in Section	S	T	R		
	S	T	R		
3. Miscellaneous Property in Sec.	S	T	R		
	S	T	R		

L.S.C.#826m

Register of Deeds Stamp & File Number

4. Lot No. \_\_\_\_\_, Recorded Plat \_\_\_\_\_  
5. Private Claims \_\_\_\_\_

A	B	C	D	E	F	G	H	I	J	K	L	M
2	5	5	4	3	2	1						
3												
4	7	8	9	10	11	12						
5												
6	10	17	16	15	14	13						
7												
8	19	20	21	22	23	24						
9												
10	30	29	28	27	26	25						
11												
12	31	32	33	34	35	36						
13												

BRYAN L. BOSS, in a field survey on SEPTEMBER 9, 1997, hereby certify that under requirements of P.A. 74, Michigan P.A. of 1970, the corner points mentioned in lines 1 and 2 above were in conformance with regulations and rules therefore as required in the current manual of survey instructions of the United States Department of the Interior, Bureau of Land Management or by a decree of a Court of Law and/or that the corner points mentioned in lines 3, 4 and 5 above were in conformance with the rules of the Michigan Board of Land Surveyors or by a Decree of a Court of Law; established, re-established, monumented, re-monumented, recovered, found as expressed below:

NOTE: Not more than 4 corners, all in the same town and range, may be recorded on this certificate.

1. Description of original monument and accessories and/or subsequent restoration:


- WHITE OAK 30" S 82 E 53 LINKS
- WHITE OAK 30" N 70 W 73 LINKS
- WHITE OAK 10" N 50 W 44 LINKS
- WHITE OAK 24" S 51 1/2 W 54 LINKS

2. Description of corner evidence found and/or method applied in restoring or reestablishing corner:

FOUND BUGGY AXLE SET BY MILES BULLOCK IN 1879.  
AXLE BROKE UPON REMOVAL AT 2 FEET DEEP.  
THE CORNER IS LOCATED 2 FEET± W OF CENTERLINE IN RED BRICK & ROCK CRIB.  
DIXBORO ROAD & 2 FEET SOUTH OF CENTERLINE OF TWELVE MILE ROAD WESTERLY.

3. Description of monument for corner and accessories established to perpetuate localing the position of the corner:

SET 1 1/4" X 30" IRON PIPE ONE FOOT BELOW GRAVEL SURFACE WITH 6" BREAKAWAY & BRASS CAP STAMPED LIVINGSTON COUNTY MONUMENTATION CORNER.  
N 08° W 119.85' NAIL & TAG EAST SIDE 15" HICKORY  
N 50° E 44.42' 3/4" PIPE BY WOOD FENCE POST  
N 75° W 122.74' NAIL & TAG SOUTH SIDE 12" ELM  
SOUTH 170.49' (3/4" PIPE IN CENTERLINE DIXBORO ROAD)  
A-6 WEST 1/4 CORNER SECTION 18, LYON TOWNSHIP

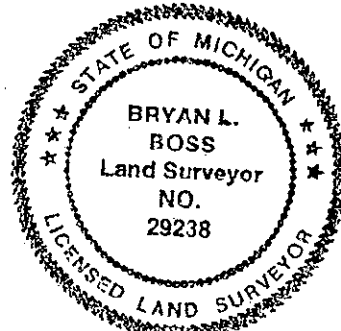

Signed by Bryan L. Boss  
Surveyor's Michigan License No. 29238

Date Sept. 22, 1997

## SUMMARY

### M-6

East 1/4 Corner, Section 13, Green Oak Township, Livingston County, Michigan.

Alex Holmes surveyed East Line of township in 1816. Miles Bullock set buggy axle stake, brick and stone in 1879. These items were found by Lyle Munsell in January 1959 from 1911 witnesses.

On February 12, 1935, Maurcie Baldwin surveyed the west line of Lyon Township, Oakland County; but makes no reference from West 1/4 corner, Section 18, Lyon Township to East 1/4 Corner, Section 13, Green Oak Township.

In March 1972, Douglas Tredinnick found point at East 1/4 corner of section and projected line North to set M-5 (The northeastt corner of Section 13). See Act 74 this dossier.

On June 21, 1979, David Finney records he found 1" solid bar and witnessed East 1/4 corner. Note: Township jog measured 170.32 feet and G.L.O. records 179.19 (271.5 links).

This intersection of Dixboro Road and Twelve Mile Road is open for G.P.S.

#### DISTANCE:

Note on page 6, this dossier, Maurice Baldwin and Boss Engineering measured southerly 2659.66 ft and 2659.18 respectively to the Southeast Corner of Section 13. David Finney and Boss Engineering measured 170.32 ft & 170.49 ft at Lyon Township jog.

#### WITNESSES:


Lyle Munsell's 1959 witnesses taken from 1911 Grant Dunning's witnesses are gone.

Number 2 witness recorded by Finney in 1979, check Boss1997 witness and Raymond Kosteke's 1985 witness numver and checks with Boss Eningeering.

Found 1" iron bar 0:80 deep and upon further digging found bar 1 ft below gravel surface possibly buggy axle.

We recommend acceptance of bar as East 1/4 Corner, Section 13.

Summ-6

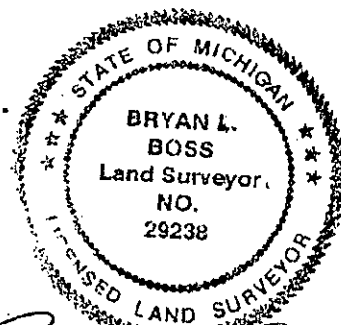

*Bryan L. Boss*