

OCT 26 1995

COMMISSION

LAND CORNER RECORDATION CERTIFICATE
Filing Requirement of Act 74, Mich. P.A. 1970

FILED

9

OCT 6 11 56 AM '95

HANCOY HAVILAND
REGISTER OF DEEDS
LIVINGSTON COUNTY, MI
48843

For corners in

<u>Livingston</u> <small>(County)</small>	Located In:	Corner Code =#
1. Public Land Survey	T <u>1N</u> R <u>6E</u>	<u>M-7</u>
	T _____ R _____	_____
	T _____ R _____	_____
	T _____ R _____	_____
2. Property Controlling in Section	S _____ T _____ R _____	_____
	S _____ T _____ R _____	_____
3. Miscellaneous Property in Sec.	S _____ T _____ R _____	_____
	S _____ T _____ R _____	_____

L.S.C. #469m
Register of Deeds Stamp & File Number

4. Lot No. _____, Recorded Plat _____
5. Private Claims _____

A	B	C	D	E	F	G	H	I	J	K	L	M
2	6	5	4	3	2	1						
3												
4	7	8	9	10	11	12						
5												
6	18	17	16	15	14	13						
7												
8	19	20	21	22	23	24						
9												
10	30	29	28	27	26	25						
11												
12	31	32	33	34	35	36						
13												

I, Bryan Boss, in a field survey on 9-6, 19 95, do hereby certify that under requirements of P.A. 74, Michigan P.A. of 1970, the corner points mentioned in lines 1 and 2 above were in conformance with regulations and rules therefore as required in the current manual of survey instructions of the United States Department of the Interior, Bureau of Land Management or by a decree of a Court of Law and/or that the corner points mentioned in lines 3, 4 and 5 above were in conformance with the rules of the Michigan Board of Land Surveyors or by a Decree of a Court of Law; established, re-established, monumented, re-monumented, recovered, found as expressed below:

NOTE: Not more than 4 corners, all in the same town and range, may be recorded on this certificate.

A. Description of original monument and accessories and/or subsequent restoration:


- White Oak S 16° W 36 links
- Hickory 10" N 41° W 4
- Black Oak 20" N 87½° W 41

B. Description of corner evidence found and/or method applied in restoring or reestablishing corner:

- Found 3/4" inch pipe one foot below surface
- 6 feet +/- East of Centerline Dixboro Road
- N 10° W 97.40' N/T E/S Power Pole
- N 20° E 34.02' N/T W/S 8" Elm
- S 50° W 22.56' N/T SE/S 6" Oak
- S 30° E 56.53' N/T W/S 24" Hickory

C. Description of monument for corner and accessories established to perpetuate locating the position of the corner:

- Set brass cap in 30" inch pipe 6" inches below surface with additional 6" breakaway
- 22.70' S 85° W nail & tag South side 6" Oak
- 33.92' N 20° E nail & tag West side 8" Elm
- 97.41' N 20° W nail & tag East side Power Pole
- 56.59' S 15° E nail & tag West side 24" Hickory

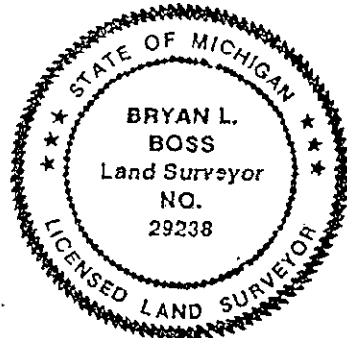

Signed by Bryan L. Boss Date Oct. 4, 1995
Surveyor's Michigan License No. 29238

SUMMARY
M-7


Northeast Corner, Section 24, T1N-R6E, Green Oak Township, Livingston County, Michigan.

Found 3/4" O.D. pipe 1 (one) foot below surface and 6 (six) feet East of centerline of Dixboro Road (Gravel). Clean sweep of area and no other irons found. No occupation East or West and location is open for G.P.S. Miles Bullock field notes in 1879 call for 40.33 chains or 2661.78 feet for split of Township line mile. Recent surveys by Boss Engineering, Washtenaw Engineering and the C & O Railroad average 2658.86 feet for the split. G.L.O. fall-in distance from Southwest Corner, Section 18, Lyon Township, Oakland County, calls for 2.53 chains (166.98 feet). C & O Railroad measured 165.1 feet and Boss Engineering measured 168 feet.

G.L.O. distance West to North 1/4 Corner of Section 24 measured 40.42 chains (2667.72 feet) compared to C & O Railroad and Boss Engineering measurements 0.87 feet apart averaging 2671.07 feet.

Conclusion: We find the recent surveys from 1988 to 1994 are in agreement with Bullock's 1879 field notes and C & O Railroad data and should be accepted as found.

GOM-7S

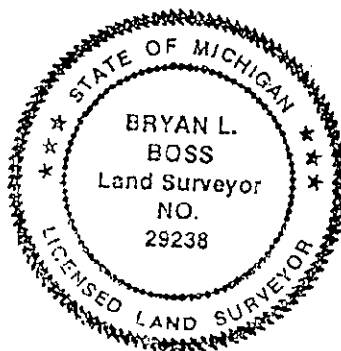

Bryan L. Boss