

LAND CORNER RECORDATION CERTIFICATE
Filing Requirement of Act 74, Mich. P.A. 1970

For corners in

-Livingston _____ (County) Located In: Corner Code #

1. Public Land Survey	T	1N	R	6E	M-8
	T		R		
	T		R		
	T		R		
2. Property Controlling In Section	S		T	R	
	S		T	R	
3. Miscellaneous Property In Sec.	S		T	R	
	S		T	R	

4. Lot No. _____, Recorded Plat _____

5. Private Claims _____

HANCOY HAVILAND
 REGISTER OF DEEDS
 LIVINGSTON COUNTY, MI
 48843
 Oct 11 10 20 AM '95

L.S.C. #481m
Register of Deeds Stamp & File Number

	A	B	C	D	E	F	G	H	I	J	K	L	M
2	6	5	4	3	2	1							
3													
4	7	8	9	10	11	12							
5													
6	18	17	16	15	14	13							
7													
8	19	20	21	22	23	24							
9													
10	30	29	28	27	26	25							
11													
12	31	32	33	34	35	36							
13													

I, Gary R. Boss, in a field survey on 10-4, 1995 do hereby certify that under requirements of P.A. 74, Michigan P.A. of 1970, the corner points mentioned in lines 1 and 2 above were in conformance with regulations and rules theretofore as required in the current manual of survey instructions of the United States Department of the Interior, Bureau of Land Management or by a decree of a Court of Law and/or that the corner points mentioned in lines 3, 4 and 5 above were in conformance with the rules of the Michigan Board of Land Surveyors or by a Decree of a Court of Law; established, re-established, monumented, re-monumented, recovered, found as expressed below:

NOTE: Not more than 4 corners, all in the same town and range, may be recorded on this certificate.

A. Description of original monument and accessories and/or subsequent restoration:

Corner in the east side of a large pond of water. No Timber
Tamarack 10" south on town line in water 4.12

B. Description of corner evidence found and/or method applied in restoring or reestablishing corner:

Found concrete monument in bog 5 feet ± off edge of open water
 N 80° 30' E 150.55' nail set south side 7" Silver Maple
 S 79° E 137.57' nail set south side 6" Silver Maple
 S 64° E 108.60' nail set south side 4" Silver Maple
 S 51° 30' E 129.05' nail set north side 14" Silver Maple


**SURVEY &
REMONUMENTATION**

NOV 27 1995

COMMISSION

C. Description of monument for corner and accessories established to perpetuate locating the position of the corner:

Set 36" pipe with brass cap.
 150.55' N 80° E nail & tag south side 7" Maple
 137.57' S 79° E nail & tag south side 6" Maple
 108.60' S 64° E nail & tag south side 4" Maple
 129.05' S 51° E nail & tag north side 14" Maple

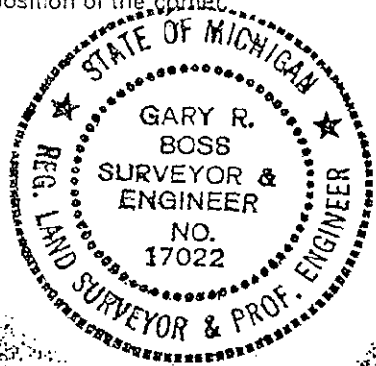

Signed by Gary R. Boss Date 10/6/95
 Surveyor's Michigan License No. 17022

SUMMARY
M-8

East 1/4 Corner, Section 24, T1N-R6E, Green Oak Township,
Livingston County, Michigan.

Found Concrete Monument

Original survey by Alex Holmes in 1816. The corner was set in the East side of a large pond of water and there was no timber for witnesses. In 1879, Miles Bullock witnessed southerly to a Tamarack 4.12 chains.

In 1968 and again in 1988, Washtenaw Engineering surveys do not make reference as East 1/4 Section 24 found or set.

Boss Engineering survey on 2-11-91 finds East 1/4 Corner as (inaccessible).

This obliterated corner was finally set by Boss Engineering on 10-12-93, by means of single proportionate distance between the Southeast corner and Northeast corner of Section 24.

Conclusion: We recommend approval of concrete monument found, set and recorded as the correct location of East 1/4 corner.

GOM-8S