

OCT 26 1995

COMMISSION

LAND CORNER RECORDATION CERTIFICATE  
Filing Requirement of Act 74, Mich. P.A. 1970

For corners in Livingston  
County

Located In: Corner Code =##

Public Land Survey T 1N R 6E M-9  
T R  
T R  
T R

Property Controlling in Section S T R  
S T R

Miscellaneous S T R

Property in Sec. S T R

OCT 6 11 57 AM 1995

REGISTER OF DEEDS  
LIVINGSTON COUNTY, MICHIGAN

L.S.C. #470m  
Register of Deeds Stamp & File Number

Lot No. \_\_\_\_\_, Recorded Plat \_\_\_\_\_  
Private Claims \_\_\_\_\_

Bryan Boss 9-15 95  
in a field survey on \_\_\_\_\_, 19 \_\_\_\_\_

I hereby certify that under requirements of P.A. 74, Michigan P.A. of 1970, the corner points mentioned in lines 1 and 2 above were in conformance with regulations and rules therefore as required in the current manual of survey instructions of the United States Department of the Interior, Bureau of Land Management or by a decree of a Court of Law and/or that the corner points mentioned in lines 3, 4 and 5 above were in conformance with the rules of the Michigan Board of Land Surveyors or by a Decree of a Court of Law; established, re-established, monumented, re-monumented, recovered, found as expressed below:

	A	B	C	D	E	F	G	H	I	J	K	L	M
2	6	5	4	3	2	1							
3													
4	7	8	9	10	11	12							
5													
6	18	17	16	15	14	13							
7													
8	19	20	21	22	23	24							
9													
10	30	29	28	27	26	25							
11													
12	31	32	33	34	35	36							
13													

NOTE: Not more than 4 corners, all in the same town and range, may be recorded on this certificate.

Description of original monument and accessories and/or subsequent restoration:


- White Oak 14" S 80° E 63 links
- White Oak 15" S 45° W 60 links
- Yellow Oak 13" N 22½° W 1.01 chains

Description of corner evidence found and/or method applied in restoring or reestablishing corner:

- Found 1½" x ¼" iron strap in red brick 2 feet ± west of centerline Dixboro Road and 105 feet ± south of centerline Ten Mile Road
- 30" Oak N 15° W 67.46' to P.K. nail
- 6" Hickory N 75° E 22.31' to P.K. nail
- 24" Hickory S 45° E 40.6'
- 14" Cedar S 30° E 49.1
- 14" Oak S 10° W 118.42' to P.K. nail

Description of monument for corner and accessories established to perpetuate locating the position of the corner:

- Set brass cap in 30" pipe 6" below surface
- 67.49' N 15° W nail & tag east side 40" Oak
- 38.62' S 30° W nail & tag east side 6" twin Walnut
- 48.59' S 20° E nail & tag west side 15" Cedar
- 22.38' N 80° E nail & tag north side 8" Walnut
- 50.02' west concrete monument

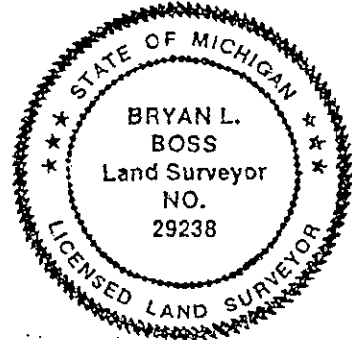

Signed by Bryan L. Boss Date Oct. 4 1995  
Surveyor's Michigan License No. 29238

SUMMARY  
M-9

Northeast Corner, Section 25, T1N-R6E, Green Oak Township,  
Livingston County, Michigan.

Found 1 1/2" x 1/4" iron strap (in red brick) 0.05 feet  
below gravel surface of Dixboro Road. this corner is two  
(2) feet ± West of centerline and approximately 105 feet ±  
South of intersection with Ten Mile Road. The area is open  
for G.P.S.


Miles Bullock's 1879 field notes call for measured distance  
of 2662.88 for split on East line of Section 25. G.L.O.  
also calls out distance at jog recorded 71.94 feet (see Act  
74 on page 15).

In comparison to 1879 survey, five survey firms ranged  
between 2660.56 feet and 2661.15 feet on the split and 2  
surveyors measured 73.26 feet at jog. Witnesses on Page 7  
confirm all surveyors have utilized the same point.

Conclusion:

We find the iron strap (in red brick) to be at the same  
location as found by Washtenaw Engineering on 6-6-68 and  
Miles Bullock witness on Page 10 (1.01 chains) 66.66 feet  
compares with number (1) on witness sheet (67.46 feet).  
Therefore we recommend it's acceptance as found.

GOM-9s

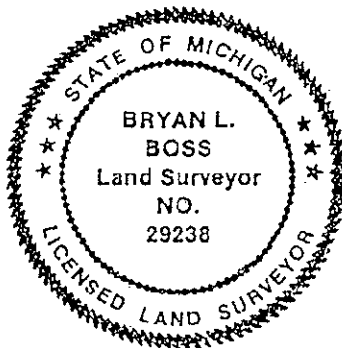

*Bryan L. Boss*