

LAND CORNER RECORDATION CERTIFICATE
Filing Requirement of Act 74, Mich. P.A. 1970

For corners in

Livingston Located In: Corner Code ##
(County)

1. Public Land Survey T 1N R 6E M-12
 T _____ R _____
 T _____ R _____
 T _____ R _____

2. Property Controlling S _____ T _____ R _____
 in Section S _____ T _____ R _____

3. Miscellaneous S _____ T _____ R _____
 Property in Sec. S _____ T _____ R _____

DEC 27 11 15 AM '93
 NANCY HAVILAND
 REGISTER OF DEEDS
 LIVINGSTON COUNTY, MI
 48843

FILED

L.S.C. # 108m

Register of Deeds Stamp & File Number

4. Lot No. _____, Recorded Plat _____
 5. Private Claims _____

	A	B	C	D	E	F	G	H	I	J	K	L	M
2	6	5	4	3	2	1							
3													
4	7	8	9	10	11	12							
5													
6	18	17	16	15	14	13							
7													
8	19	20	21	22	23	24							
9													
10	30	29	28	27	26	25							
11													
12	31	32	33	34	35	36							
13													

I, H. Lawrence O'Donnell survey on December 21, 1993, do hereby certify that under requirements of P.A. 74, Michigan P.A. of 1970, the corner points mentioned in lines 1 and 2 above were in conformance with regulations and rules therefore as required in the current manual of survey instructions of the United States Department of the Interior, Bureau of Land Management or by a decree of a Court of Law and/or that the corner points mentioned in lines 3, 4 and 5 above were in conformance with the rules of the Michigan Board of Land Surveyors or by a Decree of a Court of Law; established, re-established, monumented, re-monumented, recovered, found as expressed below:

NOTE: Not more than 4 corners, all in the same town and range, may be recorded on this certificate.

A. Description of original monument and accessories and/or subsequent restoration:

GLO survey November 1815 by Joseph Wampler
 Set gr. sec post
 Maple 13 N34W 111ks
 R. Oak 18 S15W 171ks
 (Additional historical data on back of sheet)


SURVEY &
 RECONSTRUCTION
 1893
 COMMISSION

B. Description of corner evidence found and/or method applied in restoring or reestablishing corner:

Previously recorded 1" iron pipe not found but re-established by using information from 1957 survey by Atwell-Hicks and Roskelly & Jekabson survey in 1977.

C. Description of monument for corner and accessories established to perpetuate locating the position of the corner:

Set 1-1/4" x 42" breakaway iron pipe with brass cap
 0.5' below road surface
 32" Maple S13°W 75.77' to nail w/flasher
 14" Cherry S80°E 21.78' to nail w/flasher
 16" Walnut S70°W 15.07' to nail w/flasher
 Utility pole S80°W 33.89' to nail w/flasher.

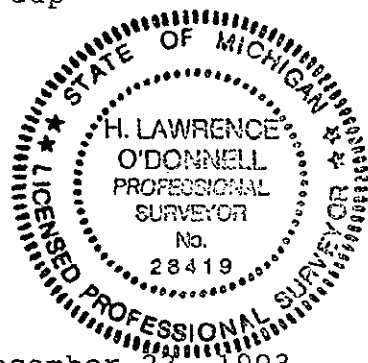

Signed by H. Lawrence O'Donnell Date December 23, 1993
 Surveyor's Michigan License No. 28419

Approved by Livingston County Monumentation Peer group November 6, 1993

Civil Engineering • Surveying
Planning • Environmental Services

A T W E L L - H I C K S , I N C .

540 Avis Drive
P.O. Box 2981
Ann Arbor, Michigan 48106
313 994 4000 • FAX: 313 994 1599

RESEARCH SUMMARY

M-12, E-1/4 Section 36, T1n, R6E

Previously recored 1" Iron pipe at the E-1/4 corner location not found.

Corner referenced in 1957 survey Atwell-Hicks, Inc.; 1971 survey by land SEA Corp.; 1972 PA 74 & 1973 survey by W.E. Co.; 1973 survey by land SEA Corp.; 1977 survey by Roskelly & Jekabson; 1979 survey by Roskelly & Jekabson; 1987 survey by W.E. Co.; 1987 survey by W.E.Co.; 1992 survey by Atwell-Hicks, Inc.

A search of the area found no irons. An iron marking the W-1/4 corner Section 31, T1N, R7E was found 20.45 feet south.

I recommend that the E 1/4 corner, Section 36, T1N, R6E, be re-established by placing it midway and on line between the NE and SE corners. This position fits the location as previously determined.



Mary A. Borkowski, RLA • William C. Henderson • Robert J. Jagow Jr., PE, PS • Robert G. Macomber, PE, PS
John L. Snyder, PE, PS • Allen R. Suggitt, PE • Richard G. Timmons, PE, PS