

9-

FILED

LAND CORNER RECORDATION CERTIFICATE
Filing Requirement of Act 74, Mich. P.A. 1970

For corners in

LIVINGSTON
(County)

Located In:

Corner Code #

- 1. Public Land Survey T 2N R 3E C-9
 T R
 T R
 T R
- 2. Property Controlling S T R
 in Section S T R
- 3. Miscellaneous S T R
 Property in Sec. S T R

1996 NOV 14 P 1:20

NANCY HAVILAND
REGISTER OF DEEDS
LIVINGSTON COUNTY, MI.
40843


L.S.C.#575m

Register of Deeds Stamp & File Number

- 4. Lot No. _____, Recorded Plat _____
- 5. Private Claims _____

I, DARRELL HUGHES, in a field survey on 11-5, 1996 do hereby state that under requirements of P.A. 74, Michigan P.A. of 1970, the corner points mentioned in lines 1 and 2 above were in conformance with regulations and rules therefore as required in the current manual of survey instructions of the United States Department of the Interior, Bureau of Land Management or by a decree of a Court of Law and/or that the corner points mentioned in lines 3, 4 and 5 above were in conformance with the rules of the Michigan Board of Land Surveyors or by a Decree of a Court of Law; established, re-established, monumented, recovered, found as expressed below:

NOTE: Not more than 2 corners, all in the same town and range, may be recorded on this certificate.

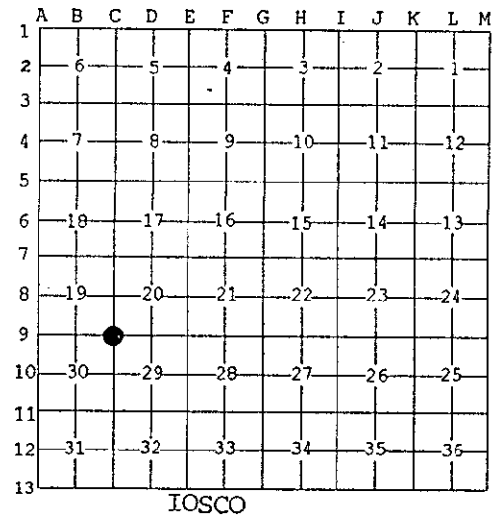

A. Description of original monument and accessories and/or subsequent restoration:

GLO: 1825
White Oak 12", South 71-1/2 degrees East, 51 links
Black Oak 8", North 53 degrees West, 28 links

B. Description of corner evidence found and/or method applied in restoring or reestablishing corner:

Found 1/2" iron pipe set by C.C. Wilson in 1972

*Additional descriptions and historical information on back of this sheet.

C. Description of monument for corner and accessories established to perpetuate locating the position of the corner:

C-9, T2N, R3E, IOSCO, replaced existing corner with 1-1/4" X 36" iron pipe, affixed with 2" dia. brass cap, stamped "Livingston Co. Monumentation Corner, P.S. 19834, and is accepted as a careful and faithful perpetuation of the position of the original corner.
003 DEG. 19.24' SET NAIL/TAG E/S 7" ELM.
320 DEG. 2.21' SET NAIL/TAG NE/S 40" OAK.
335 DEG. 23.58' SET NAIL/TAG SW/S 31" OAK.
192 DEG. 53.29' SET NAIL/TAG E/S 9" MAPLE.

Signed by Darrell Hughes
Surveyor's Michigan License No. 19834

Date November 5, 1996

IOSCO TOWNSHIP, TOWN 2 NORTH, RANGE 3 EAST

C-9, CORNER COMMON TO SECTIONS 19, 20, 29 AND 30.

FIELD: 9-30-1996 DARRELL D. HUGHES AND ASSOCIATES.

Found 1/2" iron pipe set by C.C. Wilson in 1972, at fence corner (fence corner being the 40" Oak). Pipe is at the East base of a 40" Oak. The Oak has fence wire deeply embedded in the North, South and West directions. Downed fence wire North and South. Open corn field to East and wooded to West. Marginal to Poor for GPS. Hughes used this pipe in 1979 and Garlock used it in March of 1996. I recommend, to the peer group, the acceptance of this pipe for the location of C-9.

- 1825 Sylvester Sibley, U.S. Deputy Surveyor, "North between 29 and 30, 80.00 chains, set post common to 19,20,29 and 30". P.7
- 1837 Amos Adams, county surveyor, surveys in Sec. 29. P.8
- 1861 Ezra Fairchilds, county surveyor, surveys in Sec. 19. P.9
- 1875 Miles Bullock, county surveyor, surveys Section 30. P.10
- 1875 Miles Bullock, surveys Section 29.. P.11
- 1972 Charles Wilson surveys in Section 29, sets 1/2" iron pipe at fence corner. P.12
- 1972 Charles Wilson files Act 74 for above survey. P.13
- 1979 Darrell Hughes uses pipe for survey in Sec. 20. P.14
- 1996 Charlie Garlock uses same pipe for survey in Sec. 19. P.15
- 1996 Witness list. P.16