

FILED 9-

LAND CORNER RECORDATION CERTIFICATE
Filing Requirement of Act 74, Mich. P.A. 1970

For corners in

LIVINGSTON
(County)

Located In: Corner Code #

- 1. Public Land Survey T 2N R 3E C-11
 T ___ R ___ _____
 T ___ R ___ _____
 T ___ R ___ _____
- 2. Property Controlling S ___ T ___ R ___ _____
 in Section S ___ T ___ R ___ _____
- 3. Miscellaneous S ___ T ___ R ___ _____
 Property in Sec. S ___ T ___ R ___ _____

1996 NOV 14 P 1:20

NANCY HAVILAND
REGISTER OF DEEDS
LIVINGSTON COUNTY, MI.
48043


L.S.C.#577m

Register of Deeds Stamp & File Number

- 4. Lot No. _____, Recorded Plat _____
- 5. Private Claims _____

I, DARRELL HUGHES, in a field survey on 11-6, 1996 do hereby state that under requirements of P.A. 74, Michigan P.A. of 1970, the corner points mentioned in lines 1 and 2 above were in conformance with regulations and rules therefore as required in the current manual of survey instructions of the United States Department of the Interior, Bureau of Land Management or by a decree of a Court of Law and /or that the corner points mentioned in lines 3, 4 and 5 above were in conformance with the rules of the Michigan Board of Land Surveyors or by a Decree of a Court of Law; established, re-established, monumented, recovered, found as expressed below.

NOTE: Not more than 2 corners, all in the same town and range, may be recorded on this certificate.

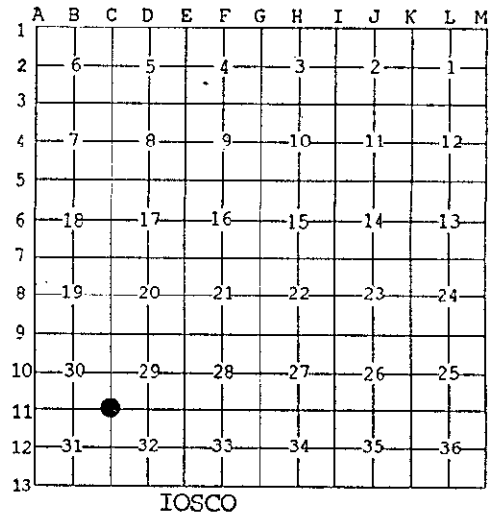

A. Description of original monument and accessories and/or subsequent restoration:
GLO: 1825
Black Oak 7", South 02 degrees East, 21 links
Black Oak 8", North 18-1/2 degrees East, 32 links

B. Description of corner evidence found and/or method applied in restoring or reestablishing corner:
Found 1/2" iron pipe set by C.C. Wilson in 1972.

*Additional descriptions and historical information on back of this sheet.

C. Description of monument for corner and accessories established to perpetuate locating the position of the corner:

C-11, T2N, R3E, IOSCO, replaced existing corner with 1-1/4" X 36" iron pipe, affixed with 2" dia. brass cap, stamped "Livingston Co. Monumentation Corner, P.S. 19834, and is accepted as a careful and faithful perpetuation of the position of the original corner.
175 DEG. 23.68' SET NAIL/TAG W/S 18" OAK.
016 DEG. 38.38' SET NAIL/TAG W/S 20" OAK.
113 DEG. 64.85' SET NAIL/TAG SW/S 10" BOX ELDER.
305 DEG. 49.13' SET NAIL/TAG SW/S UTILITY POLE.

Signed by [Signature]
Surveyor's Michigan License No. 19834

Date November 6, 1996

IOSCO TOWNSHIP, T2N, R3E

C-11, CORNER COMMON TO SECTIONS 29, 30, 31 AND 32.

FIELD: 9-27-1996

FOUND 1/2" IRON PIPE, SET BY WILSON IN 1972, 2' NORTH OF CL ROBERTS RD. ON OCCUPIED LINE TO SOUTH. 0.5' BELOW GRADE. MARGINAL FOR GPS. ALL SURVEYORS SINCE HAVE USED THIS PIPE. I RECOMMEND, TO THE PEER GROUP, THE ACCEPTANCE OF THE PIPE FOR THE LOCATION OF C-11.

- 1825 - Sylvester Sibley, U.S. Deputy Surveyor, "North between Section 31 and 32, 80.00 chains, set post common to 29,30,31 and 32". P.7
- 1840 Amos Adams, county surveyor, uses corner in survey. P.8
- 1875 Miles Bullock, county surveyor, uses corner in surveys of Section 30 and 29. P.9
- 1972 Charles Wilson sets 1/2" iron pipe and files Act 74. P.10
- 1973 Robert Jagow uses iron pipe in survey, files Act 74. P.11-12
- 1974 Oscar Boss uses iron pipe in survey. P.13
- 1976 Oscar Boss uses same pipe in survey. P.14
- 1979 Austin Williams uses same pipe in survey. P.15
- 1990 Matt Brady uses same pipe in survey. P.16
- 1996 Witness list. P.17
- 1996 Ray KostECKE survey shows corner, no witnesses. P.18