

9-
FILED

LAND CORNER RECORDATION CERTIFICATE
Filing Requirement of Act 74, Mich. P.A. 1970

For corners in

<u>LIVINGSTON</u> (County)	Located In:	Corner Code #
1. Public Land Survey	T <u>2N</u> R <u>3E</u>	<u>D-11</u>
	T ___ R ___	_____
	T ___ R ___	_____
	T ___ R ___	_____
2. Property Controlling in Section	S ___ T ___ R ___	_____
	S ___ T ___ R ___	_____
3. Miscellaneous Property in Sec.	S ___ T ___ R ___	_____
	S ___ T ___ R ___	_____

1996 NOV 14 P 1:22

NANCY HAVILAND
REGISTER OF DEEDS
LIVINGSTON COUNTY, MI.
48843

L.S.C.#599m

Register of Deeds Stamp & File Number

4. Lot No. _____, Recorded Plat _____
5. Private Claims _____

I, DARRELL HUGHES, in a field survey on 11-5, 1996 do hereby state that under requirements of P.A. 74, Michigan P.A. of 1970, the corner points mentioned in lines 1 and 2 above were in conformance with regulations and rules therefore as required in the current manual of survey instructions of the United States Department of the Interior, Bureau of Land Management or by a decree of a Court of Law and /or that the corner points mentioned in lines 3, 4 and 5 above were in conformance with the rules of the Michigan Board of Land Surveyors or by a Decree of a Court of Law; established, re-established, monumented, recovered, found as expressed below:

NOTE: Not more than 2 corners, all in the same town and range, may be recorded on this certificate.

1	A	B	C	D	E	F	G	H	I	J	K	L	M
2		6		5		4		3		2		1	
3													
4		7		8		9		10		11		12	
5													
6		18		17		16		15		14		13	
7													
8		19		20		21		22		23		24	
9													
10		30		29		28		27		26		25	
11				●									
12		31		32		33		34		35		36	
13													

IOSCO

A. Description of original monument and accessories and/or subsequent restoration:

GLO: 1825
Black Oak 30", North 81-1/2 degrees East, 52 links
Black Oak 22", North 51 degrees West, 82 links

B. Description of corner evidence found and/or method applied in restoring or reestablishing corner:

Found 3/4" x 1-1/2" iron bar


*Additional descriptions and historical information on back of this sheet.

C. Description of monument for corner and accessories established to perpetuate locating the position of the corner:

D-11, T2N, R3E, IOSCO, replaced existing corner with 1-1/4" X 36" iron pipe, affixed with 2" dia. brass cap, stamped "Livingston Co. Monumentation Corner, P.S. 19834, and is accepted as a careful and faithful perpetuation of the position of the original corner.
160 DEG. 59.97' SET NAIL/TAG NE/S 20" OAK.
086 DEG. 84.05' SET NAIL/TAG S/S 48" OAK.
288 DEG. 63.43' SET NAIL/TAG NE/S 6" OAK.
343 DEG. 99.29' SET NAIL/TAG E/S 15" OAK.

Signed by Darrell Hughes
Surveyor's Michigan License No. 19834

Date November 5, 1996

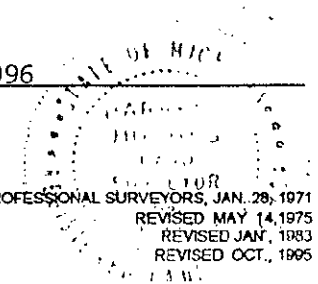

IOSCO TOWNSHIP, T2N, R3E

D-11, SOUTH 1/4 COR. SEC. 29 AND NORTH 1/4 COR. SEC. 32.

FIELD: 9-27-1996 DARRELL D. HUGHES AND ASSOCIATES.

Found 3/4" X 1-1/2" iron bar from C.C. Wilson Act 74, 1972. On Wilson survey a "iron pipe" (found to be solid iron rod) is shown falling S35W 19.65' and is called the Northwest corner of "Oak Ridge" Subdivision. From present measures, I concur. All surveyors since, except Brady, have used the iron bar for D-11. I dug up the iron bar and found it to be a leaf spring, lying flat and turned up at one end. Perhaps this spring fell off some vehicle and was buried? The solid rod (Northwest corner of "Oak Ridge") fits the Wright Cemetery fence at the Northeast corner of Dutton and Roberts. However, not to upset all of the monumentation that has transpired since, I recommend, to the peer group, the acceptance of the "Wilson" iron bar (leaf spring) for the location of D-11.

- 1825 Sylvester Sibley, U.S. Deputy Surveyor, "West corrected between 26 and 32, 39.86 chains, set 1/4 post". P.7
- 1837 Amos Adams, county surveyor, begins survey "at the stake". P.8
- 1875 Miles Bullock, county surveyor, divides Section 29. P. 9
- 1954 Sumner Hall, Civil Eng. #160, Plats "Oak Ridge". He shows "1 inch iron stake" at centerline of Dutton and Roberts and does not label the North and West lines of the subdivision as the section lines, but implies it by saying the sub. is the West 1/2 of the NE 1/4. P.10
- 1972 C.C. Wilson finds "bar" for D-11, shows relationship to NW corner of "Oak Ridge" and files Act 74. P.11-12
- 1973 Garlock divides lot in "Oak Ridge", traverses subdivision and shows relationship with section and road centerlines. Calls out "iron bar" for D-11. P.13
- 1973 Robert Jagow uses "rectangular bar 3/4 X 2-1/2" for D-11. P.14
- 1976 Oscar Boss "finds rectangular bar" in survey. P.15
- 1981 Brad Thompson "finds rectangular bar per C. Wilson" and uses in survey for C-11. P.16
- 1983 Charlie Garlock uses "found iron bar" for corner. P.17
- 1990 Matt Brady "found 1" iron pipe", witnesses check for 1" rod at northwest corner of "Oak Ridge". P.18
- 1993 Darrell Hughes, retraces and divides Parcel 13, of Wilson survey, uses iron bar. No witnesses shown. P.19
- 1996 Witness list. P.20