

FILED  
 Oct 16 11 43 AM '95  
 NANCY HAVILAND  
 REGISTER OF DEEDS  
 LIVINGSTON COUNTY, MI  
 48843

LAND CORNER RECORDATION CERTIFICATE  
 Filing Requirement of Act 74, Mich. P.A. 1970

9

or corners in  
LIVINGSTON  
 (County)  
 Located In: Corner Code #  
 Public Land Survey T 2N R 3E E-12  
 T \_\_\_\_\_ R \_\_\_\_\_  
 T \_\_\_\_\_ R \_\_\_\_\_  
 T \_\_\_\_\_ R \_\_\_\_\_  
 Property Controlling S \_\_\_\_\_ T \_\_\_\_\_ R \_\_\_\_\_  
 in Section S \_\_\_\_\_ T \_\_\_\_\_ R \_\_\_\_\_  
 Miscellaneous S \_\_\_\_\_ T \_\_\_\_\_ R \_\_\_\_\_  
 Property in Sec. S \_\_\_\_\_ T \_\_\_\_\_ R \_\_\_\_\_

L. S. C. # 485m  
 Register of Deeds Stamp & File Number

Lot No. \_\_\_\_\_, Recorded Plat \_\_\_\_\_  
 Private Claims \_\_\_\_\_

DARRELL HUGHES, in a field survey on FEBRUARY 22, 1995,  
 hereby certify that under requirements of P.A. 74, Michigan P.A. of 1970, the corner points mentioned  
 in lines 1 and 2 above were in conformance with regulations and rules therefore as required in the  
 current manual of survey instructions of the United States Department of the Interior, Bureau of Land  
 Management or by a decree of a Court of Law and/or that the corner points mentioned in lines 3, 4 and 5  
 above were in conformance with the rules of the Michigan Board of Land Surveyors or by a Decree of a  
 Court of Law; established, re-established, monumented, re-monumented, recovered, found as  
 pressed below:

	A	B	C	D	E	F	G	H	I	J	K	L	M
2	6		5		4		3		2		1		
3													
4	7		8		9		10		11		12		
5													
6	18		17		16		15		14		13		
7													
8	19		20		21		22		23		24		
9													
10	30		29		28		27		26		25		
11													
12	31		32		33		34		35		36		
13													

NOTE: Not more than 4 corners, all in the same town and range, may be recorded  
 on this certificate.

IOSCO TWP.

Description of original monument and accessories and/or subsequent restoration:  
 GLO: 1825, Sylvester Sibley, Deputy Surveyor  
 Black Oak 9", North 9 degrees West, 18 links  
 Black Oak 10", South 9 degrees East, 46 links

SURVEY &  
 REMONUMENTATION


NOV 27 1995

COMMISSION

Description of corner evidence found and/or method applied in restoring or reestablishing corner:  
 Found 3/4 inch iron pipe. Cap No. 33971

\*Additional descriptions and historical information on back of this sheet.

Description of monument for corner and accessories established to perpetuate locating the position of the corner:  
 E-12, T2N, R3E, IOSCO, replaced existing corner with 1-1/4" X 36" iron  
 pipe, affixed with 2" dia. brass cap, stamped "Livingston Co.  
 Monumentation Corner, P.S. 19834, and is accepted as a careful and  
 faithful reestablishment of the position of the original corner.  
 004 DEG. 29.16' SET NAIL/TAG W/S 18" TRIPLE RED OAK.  
 039 DEG. 3.51' SET NAIL/TAG W/S 16" CHERRY.  
 360 DEG. 16.68' SET NAIL/TAG W/S 12" CHERRY.  
 272 DEG. 25.71' SET NAIL/TAG N/S 48" RED OAK.

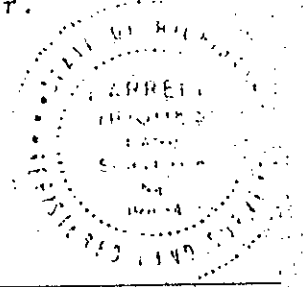

Signed by Darrell Hughes Date October 5, 1995  
 Surveyor's Michigan License No. 19834

P.A. 345 1990, APPROVED BY LIVINGSTON COUNTY

IOSCO TOWNSHIP, T2N, R3E

E-12, EAST 1/4 COR. SEC. 32, WEST 1/4 COR. SEC. 33

FIELD 06-23-1994 Darrell D. Hughes and Associates

Fd. 3/4" iron pipe with cap #33971 in center of old wood post hole, surrounded with stones.

GPS- In wooded area, not good for GPS.

1825 Sylvester Sibley, U.S. Deputy Surveyor, North between 32 and 33, 40.00 chains set 1/4 post. (P.7)

1991 Mary Barnwell sets 3/4" iron pipe in fence post hole. (P.8)

1994 Darrell Hughes finds 3/4" iron pipe and existing witness'. (P.9-10)  
E-12 to E-13, 2650.69' Barnwell 1991, 2650.87' Hughes 1994,  
2650.95' Hughes 1995.