

MAR 17 2000

SECTION

LAND CORNER RECORDATION CERTIFICATE
Filing Requirement of Act 74, Mich. P.A. 1970

FILED

For corners in

<u>LIVINGSTON</u> (County)	Located In:	Corner Code #
1. Public Land Survey	T <u>2</u> N R <u>3</u> E	<u>G-9</u>
	T _____ R _____	_____
	T _____ R _____	_____
	T _____ R _____	_____
2. Property Controlling in Section	S _____ T _____ R _____	_____
	S _____ T _____ R _____	_____
3. Miscellaneous Property in Sec.	S _____ T _____ R _____	_____
	S _____ T _____ R _____	_____

1999 NOV 22 A 10:06

NANCY HAVILAND
REGISTER OF DEEDS
LIVINGSTON COUNTY, MI.
48843


J.S.C #1062m
Register of Deeds Stamp & File Number

4. Lot No. _____, Recorded Plat _____

5. Private Claims _____

I, DARRELL D. HUGHES, in a field survey on NOVEMBER 3, 1999 do hereby state that under requirements of P.A. 74, Michigan P.A. of 1970, the corner points mentioned in lines 1 and 2 above were in conformance with regulations and rules therefore as required in the current manual of survey instructions of the United States Department of the Interior, Bureau of Land Management or by a decree of a Court of Law and/or that the corner points mentioned in lines 3, 4 and 5 above were in conformance with the rules of the Michigan Board of Land Surveyors or by a Decree of a Court of Law; established, re-established, monumented, recovered, found as expressed below:

NOTE: Not more than 2 corners, all in the same town and range, may be recorded on this certificate.

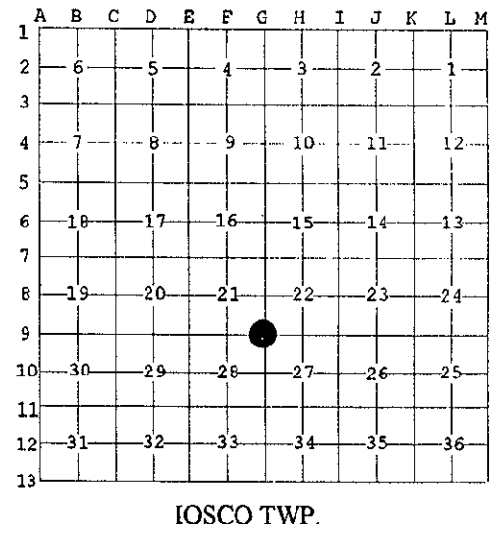

A. Description of original monument and accessories and/or subsequent restoration:

GLO: 1825 Sylvester Sibley, Deputy Surveyor
ASPEN 9" S72E 44 LINKS
WHITE OAK 12" N34½E 90 LINKS

* ADDITIONAL HISTORICAL INFORMATION ON BACK OF SHEET

B. Description of corner evidence found and/or method applied in restoring or reestablishing corner:

FOUND ½" IRON REROD 4' WEST OF CENTER LINE 20 FEET WIDE GRAVEL ROAD, 0.4' BELOW GRADE. RIGHT OF WAY IRONS AND OCCUPATION TO EAST AND WEST.

C. Description of monument for corner and accessories established to perpetuate locating the position of the corner:

G-9, T2N, R3E, IOSCO, set corner with 3/4" x 36" iron pipe. affixed with 2" dia. Brass disk.
Disk stamped "Livingston Co. Monumentation Corner, 19834" and is accepted as a careful and faithful reestablishment of the position of the original corner.

- 096 DEGREES 31.55' SET NAIL/TAG S/S UTILITY POLE.
- 163 DEGREES 56.55' SET NAIL/TAG W/S 24" OAK.
- 271 DEGREES 20.15' SET NAIL/TAG N/S 12" ELM.
- 325 DEGREES 50.48' SET NAIL/TAG NE/S 26" OAK.

PA. 345 1980, APPROVED BY LIVINGSTON COUNTY
PEER GROUP ON 2-3-99 CO. REP JED

Signed by Darrell D. Hughes Date NOVEMBER 3, 1999

Surveyor's Michigan License No. 19834