

**SURVEY & REMONUMENTATION**

**FILED**

APR 28 1995

**LAND CORNER RECORDATION CERTIFICATE**  
Filing Requirement of Act 74, Mich. P.A. 1970

Nov 16 1 59 PM '94

**COMMISSION**

NANCY HAVILAND  
REGISTER OF DEEDS  
LIVINGSTON COUNTY, MI  
48843

For corners in

<u>LIVINGSTON</u> (County)	Located In:	Corner Code #
1. Public Land Survey	T <u>2N</u> R <u>3E</u>	<u>G-11</u>
	T _____ R _____	_____
	T _____ R _____	_____
	T _____ R _____	_____
2. Property Controlling in Section	S _____ T _____ R _____	_____
	S _____ T _____ R _____	_____
3. Miscellaneous Property in Sec.	S _____ T _____ R _____	_____
	S _____ T _____ R _____	_____

L.S.C.#325m

Register of Deeds Stamp & File Number

4. Lot No. \_\_\_\_\_, Recorded Plat \_\_\_\_\_  
5. Private Claims \_\_\_\_\_

	A	B	C	D	E	F	G	H	I	J	K	L	M
2	6		5		4		3		2		1		
3													
4	7		8		9		10		11		12		
5													
6	18		17		16		15		14		13		
7													
8	19		20		21		22		23		24		
9													
10	30		29		28		27		26		25		
11													
12	31		32		33		34		35		36		
13													

IOSCO TWP.

DARRELL HUGHES in a field survey on NOVEMBER 2, 1994  
Do hereby certify that under requirements of P.A. 74, Michigan P.A. of 1970, the corner points mentioned in lines 1 and 2 above were in conformance with regulations and rules therefore as required in the current manual of survey instructions of the United States Department of the Interior, Bureau of Land Management or by a decree of a Court of Law and/or that the corner points mentioned in lines 3, 4 and 5 above were in conformance with the rules of the Michigan Board of Land Surveyors or by a Decree of a Court of Law, established, re-established, monumented, re-monumented, recovered, found as expressed below:

**NOTE: Not more than 4 corners, all in the same town and range, may be recorded on this certificate.**

A. Description of original monument and accessories and/or subsequent restoration:

GLO: 1825 Sylvester Sibley, Deputy Surveyor  
Black Oak 13" N 58½ E 35 links  
Black Oak 10" N 69½ W 40 links

\* Additional historical information on back of sheet


B. Description of corner evidence found and/or method applied in restoring or reestablishing corner:

Fd. 1/2" iron pipe at center of road intersection

C. Description of monument for corner and accessories established to perpetuate locating the position of the corner:

G-11, T2N, R3E, IOSCO, replaced existing corner with 1-1/4" X 36" iron pipe, affixed with 2" dia. brass disk. Disk stamped "Livingston Co. Monumentation Corner, 19834" and is accepted as a careful and faithful reestablishment of the position of the original corner.  
025 DEG. 78.53' SET NAIL/TAG W/S 16" CHERRY.  
073 DEG. 66.20' SET NAIL/TAG S/S 16" TRIPLE CHERRY.  
165 DEG. 72.20' SET NAIL W/S UTILITY POLE.  
315 DEG. 37.43' SET NAIL NE/S 6" DIA. WOOD COR. POST.

Signed by Darrell Hughes Date November 2, 1994  
Surveyor's Michigan License No. 19834

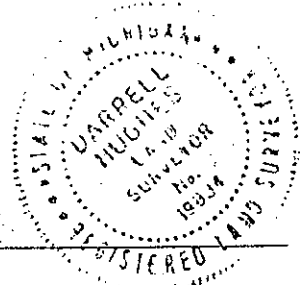

FORM APPROVED BY MICHIGAN STATE BOARD OF LAND SURVEYORS, JAN. 28, 1971  
REVISED MAY 14, 1975  
REVISED JAN., 1983

PA. 345 1990, APPROVED BY LIVINGSTON COUNTY  
PEER GROUP ON 3 Aug 94 CO. REP Rab Li

IOSCO TOWNSHIP, T2N, R3E

G-11, CORNER COMMON TO SECTIONS 27, 28, 33, AND 34.

FIELD 3-8-1994 D.D.HUGHES AND ASSOCIATES, FOWLerville.

Found 1/2" iron pipe (hit and on its side). Reset 1/2" iron rod 6" below grade from witness' in recorded corner no. 203. P.10. Wood corner post tie did not fit. Post leaning, disregarded. set new ties. P. 15A, corner falls a center of intersecting roads. OK for GPS. Measures to south and east agree within reason with other surveys (See).

1825 Sylvester Sibley, Deputy U.S. Surveyor, set post. Corner East 40.09 chains.

1872 Miles Bullock divided all of Section 34, P.8.

1972 Wilson sets 1/2" iron pipe and files Act 74.P.10.

1973 Benton survey "found 1/2" iron rod". Witness' agree, somewhat, with Wilson.

1987 Hughes finds iron pipe. copies Wilson ties. P.14A.

1994 Hughes finds pipe on side and resets from Wilson ties. P.15.