

SURVEY & REMONUMENTATION

FILED

APR 28 1995

LAND CORNER RECORDATION CERTIFICATE
Filing Requirement of Act 74, Mich. P.A. 1970

Nov 16 2 00 PM '94

NANCY HAVILAND
REGISTER OF DEEDS
LIVINGSTON COUNTY, MI
48843

For corners in **COMMISSION**

LIVINGSTON (County)	Located In:	Corner Code #
1. Public Land Survey	T <u>2N</u> R <u>3E</u>	<u>H-11</u>
	T _____ R _____	_____
	T _____ R _____	_____
	T _____ R _____	_____
2. Property Controlling in Section	S _____ T _____ R _____	_____
	S _____ T _____ R _____	_____
3. Miscellaneous Property in Sec.	S _____ T _____ R _____	_____
	S _____ T _____ R _____	_____

L.S.C. #328m

Register of Deeds Stamp & File Number

4. Lot No. _____, Recorded Plat _____
5. Private Claims _____

	A	B	C	D	E	F	G	H	I	J	K	L	M
2	6	5	4	3	2	1							
3													
4	7	8	9	10	11	12							
5													
6	18	17	16	15	14	13							
7													
8	19	20	21	22	23	24							
9													
10	30	29	28	27	26	25							
11													
12	31	32	33	34	35	36							
13													

IOSCO TWP.

DARRELL HUGHES, in a field survey on NOVEMBER 2, 19 94,
do hereby certify that under requirements of P.A. 74, Michigan P.A. of 1970, the corner points mentioned
in lines 1 and 2 above were in conformance with regulations and rules therefore as required in the
current manual of survey instructions of the United States Department of the Interior, Bureau of Land
Management or by a decree of a Court of Law and/or that the corner points mentioned in lines 3, 4 and 5
above were in conformance with the rules of the Michigan Board of Land Surveyors or by a Decree of a
Court of Law; established, re-established, monumented, re-monumented, recovered, found as
expressed below:

-NOTE: Not more than 4 corners, all in the same town and range, may be recorded on this certificate.

A. Description of original monument and accessories and/or subsequent restoration:

GLO: 1825 Sylvester Sibley, Deputy Surveyor
Black Oak 12" North 57 degrees West 20 links
Black Oak 7" South 67½ degrees West 54 links


*Additional historical information on back of sheet

B. Description of corner evidence found and/or method applied in restoring or reestablishing corner:

Fd. 1/2" iron rod with Boss cap

C. Description of monument for corner and accessories established to perpetuate locating the position of the corner:

H-11, T2N, R3E, IOSCO, replaced existing corner with 1-1/4" X 36" iron pipe, affixed with 2" dia. brass disk. Disk stamped "Livingston Co. Monumentation Corner, 19834" and is accepted as a careful and faithful reestablishment of the position of the original corner.
007 DEG. 29.16' SET NAIL/TAG W/S 6" DIA. WOOD FENCE POST.
103 DEG. 68.20' SET NAIL/TAG N/S 22" OAK.
164 DEG. 18.16' SET NAIL/TAG W/S 12" TWIN OAK.
250 DEG. 36.69' SET NAIL/TAG N/S 14" OAK.
183 DEG. 32.90' FD. 1/2" IRON ROD.

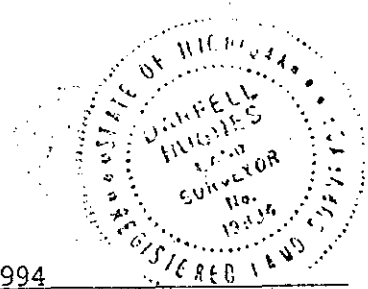

signed by Darrell Hughes
Surveyor's Michigan License No. 19834

Date November 3, 1994

IOSCO TOWNSHIP, T2N, R3E

H-11, NORTH 1/4 COR. SEC. 34, SOUTH 1/4 COR. SEC. 27.

FIELD 03-01-1994 D.D.HUGHES AND ASSOCIATES, FOWLerville.

Found 1/2" iron rod with Boss cap, 5.5' South of CL Roberts Road. Fd. one Boss witness in fence post North, measures 0.26' long. P.9 & 14A. Marginal for GPS. No witness' given by Benton. Measures of 1/2 mile to West different by 0.83', Benton survey. 0.50' differ to South, Boss, 0.33'differ to East, Boss.

1825 Sylvester Sibley, Deputy U.S. Surveyor, set 1/4 post 40.09 chains (2645.94') East and West.P.7

1872 Miles Bullock divides all of Section 34.P.8

1973-1989 Boss, Benton, Brady and Hughes used corner.P.9-14.