

SURVEY & REMONUMENTATION

FILED

APR 28 1995

LAND CORNER RECORDATION CERTIFICATE
Filing Requirement of Act 74, Mich. P.A. 1970

Nov 16 2 00 PM '94

NANCY HAVILAND
REGISTER OF DEEDS
LIVINGSTON COUNTY, MI
48843

COMMISSION

For corners in LIVINGSTON (County) Located In: Corner Code ##

1. Public Land Survey	T	<u>2N</u>	R	<u>3E</u>	<u>H-13</u>
	T	_____	R	_____	_____
	T	_____	R	_____	_____
	T	_____	R	_____	_____
2. Property Controlling in Section	S	_____	T	_____	R
	S	_____	T	_____	R
3. Miscellaneous Property in Sec.	S	_____	T	_____	R
	S	_____	T	_____	R

L.S.C. #329m

Register of Deeds Stamp & File Number

4. Lot No. _____, Recorded Plat _____
5. Private Claims _____

DARRELL HUGHES, in a field survey on NOVEMBER 2, 19 94, do hereby certify that under requirements of P.A. 74, Michigan P.A. of 1970, the corner points mentioned in lines 1 and 2 above were in conformance with regulations and rules therefore as required in the current manual of survey instructions of the United States Department of the Interior, Bureau of Land Management or by a decree of a Court of Law and/or that the corner points mentioned in lines 3, 4 and 5 above were in conformance with the rules of the Michigan Board of Land Surveyors or by a Decree of a Court of Law; established, re-established, monumented, re-monumented, recovered, found as expressed below:

NOTE: Not more than 4 corners, all in the same town and range, may be recorded on this certificate.


1. Description of original monument and accessories and/or subsequent restoration:
GLO: 1825 Sylvester Sibley, Deputy Surveyor
White Oak 16" North 1 degree West 128 links
White Oak 17" North 61 degrees East 166 links

	A	B	C	D	E	F	G	H	I	J	K	L	M
2	6		5		4		3		2		1		
3													
4	7		8		9		10		11		12		
5													
6	18		17		16		15		14		13		
7													
8	19		20		21		22		23		24		
9													
10	30		29		28		27		26		25		
11													
12	31		32		33		34		35		36		
13													

IOSCO TWP.

*Additional historical information on back of sheet
2. Description of corner evidence found and/or method applied in restoring or reestablishing corner:
Fd. 1 1/4 inch iron pipe in rock pile

Description of monument for corner and accessories established to perpetuate locating the position of the corner:
H-13, T2N, R3E, IOSCO, left existing iron pipe, affixed with 2" dia. brass disk. Disk stamped "Livingston Co. Monumentation Corner, 19834" and is accepted as a careful and faithful reestablishment of the position of the original corner.
360 DEG. 9.2' S/S LARGE ROCK.
105 DEG. 51.27' SET NAIL/TAG N/S 28" OAK.
191 DEG. 11.40' SET NAIL/TAG E/S 10" OAK.
270 DEG. 4.37' SET NAIL/TAG S/S 10" CHERRY.
328 DEG. 11.02' SET NAIL/TAG NE/S 16" OAK.

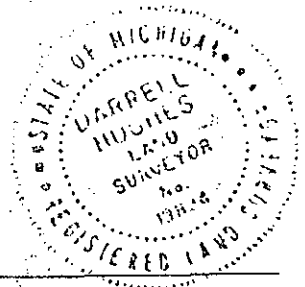

Signed by Darrell Hughes Date November 3, 1994
Surveyor's Michigan License No. 19834

IOSCO TOWNSHIP, T2N, R3E

H-13, SOUTH 1/4 CORNER SECTION 34

FIELD 2-22-1994 D.D.HUGHES AND ASSOCIATES

Found 1-1/4" iron pipe in rock pipe, set by Wilson in 1972, (P.11-12) "from GLO accessories". Tree row to North and East. Old downed fence N/S and E/W. Witness' match Wilson and Barnwell (P.12 and P.15A), Boss copied Wilson's witness' P.14A. Treed area, not good for GPS. 143.07' West to calculated H-1, Unadilla (Ed. monumented corner 2.18' South of Township line.)P.17A.

1825 Sylvester Sibley, U.S. Deputy Surveyor, set 1/4 post at 40 chains.P.7.

1872 Miles Bullock divides all of Section 34. P.8, 40.07 chains (2644.62') West to G-13, 40.16 chains 2650.56' East to I-13, 40.02 chains (2641.32') North to H-12.

1953 Clay Gorden survey uses corner, shows falling to West H-1 to be 142.8'.P.09. West to G-13 2646.50' or 2645.90', North to H-12 2639.07'.

1972 Wilson sets 1-1/4" pipe " from GLO accessories" and files Act 74. P.11-12

1973 Boss survey P.13-14

1993 Barnwell survey P15.

1994 Hughes survey P.16-17.