

SURVEY & REMONUMENTATION

LAND CORNER RECORDATION CERTIFICATE

APR 28 1995

Filing Requirement of Act 74, Mich. P.A. 1970

FILED

NOV 16 2 00 PM '94

NANCY HAVILAND
REGISTER OF DEEDS
LIVINGSTON COUNTY, MI
48843

L.S.C. #330m

Register of Deeds Stamp & File Number

LIVINGSTON
(County)

COMMISSION

Corner Code #

- 1. Public Land Survey T 2N R 3E I-11
T _____ R _____
T _____ R _____
T _____ R _____
- 2. Property Controlling S _____ T _____ R _____
in Section S _____ T _____ R _____
- 3. Miscellaneous S _____ T _____ R _____
Property in Sec. S _____ T _____ R _____

- 4. Lot No. _____, Recorded Plat _____
- 5. Private Claims _____

DARRELL HUGHES in a field survey on NOVEMBER 2, 19 94

Do hereby certify that under requirements of P.A. 74, Michigan P.A. of 1970, the corner points mentioned in lines 1 and 2 above were in conformance with regulations and rules therefore as required in the current manual of survey instructions of the United States Department of the Interior, Bureau of Land Management or by a decree of a Court of Law and/or that the corner points mentioned in lines 3, 4 and 5 above were in conformance with the rules of the Michigan Board of Land Surveyors or by a Decree of a Court of Law; established, re-established, monumented, re-monumented, recovered, found as expressed below:

NOTE: Not more than 4 corners, all in the same town and range, may be recorded on this certificate.

Description of original monument and accessories and/or subsequent restoration:

GLO: 1825 Sylvester Sibley, Deputy Surveyor
White Oak 14" South 51½ degrees East 42 links
White Oak 30" North 60 degrees West 28 links

*Additional historical information on back of sheet

Description of corner evidence found and/or method applied in restoring or reestablishing corner:

Fd. 1/2" iron rod in top center wood corner fence post

Description of monument for corner and accessories established to perpetuate locating the position of the corner:


I-11, T2N, R3E, IOSCO, removed rotted corner fence post, replaced existing corner with 1-1/4" X 36" iron pipe, affixed with 2" dia. brass disk. Disk stamped "Livingston Co. Monumentation Corner, 19834" and is accepted as a careful and faithful reestablishment of the position of the original corner.
035 DEG. 39.98' SET NAIL/TAG SE/S 8" ELM.
265 DEG. 96.24' SET NAIL/TAG N/S UTILITY POLE.
282 DEG. 19.49' SET NAIL/TAG N/S TWIN 5" TREE.
075 DEG. 22.38' SET NAIL/TAG N/S 12" ELM.

	A	B	C	D	E	F	G	H	I	J	K	L	M
2	6		5		4		3		2		1		
3													
4	7		8		9		10		11		12		
5													
6	18		17		16		15		14		13		
7													
8	19		20		21		22		23		24		
9													
10	30		29		28		27		26		25		
11													
12	31		32		33		34		35		36		
13													

IOSCO TWP.

Signed by Darrell Hughes Date November 3, 1994

Surveyor's Michigan License No. 19834

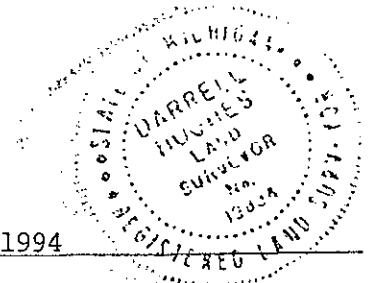

FORM APPROVED BY MICHIGAN STATE BOARD OF LAND SURVEYORS, JAN. 28, 1971
REVISED MAY 14, 1975
REVISED JAN., 1983

PA. 345 1890, APPROVED BY LIVINGSTON COUNTY
PEER GROUP ON 3 Aug. 94, CO. REP R. A. L.

IOSCO TOWNSHIP, T2N, R3E

I-11, CORNER COMMON TO SECTIONS 34-35-26-25.

FIELD 02-22-1994 D.D.HUGHES AND ASSOCIATES, FOWLerville.

Found 1/2" iron rod in top center 5' high, 8" dia. wood corner fence post, wire to south and west. Iron possible set by Lyle Munsell in 1967 P. 10. Corner, when reset will be good for future GPS. Corner is 150'+/- East of cl Bull Run Road. P.18B. Munsell, Garlock, Boss and Brady have used and witnessed this corner. Measures: I-11 to J-11 2641.98 GLO, P.07, 2650.56' Bullock "in the dark" P.08A, 2652.33' Boss P.12, 2652.85' Boss P.19, Hughes 2652.81' P.18; I-11 to H-11, GLO 2645.94' P.7A, Bullock 2658.48' P.08, 2657.95' Boss P.16, 2657.55' Brady P.21, Hughes 2657.72'; I-11 to I-12, GLO 2640', Bullock 2641.32' P. 08, Boss 2624.76' P.16, Hughes 2626.18' P.18.

1825 Sylvester Sibley, U.S. Deputy Surveyor, set corner post. P.07.

1872 Miles Bullock, divides all of Sec. 34 P.08.

1938 Clay Gordon uses corner P.09.

1967 Lyle Munsell uses corner P.10.

1972-1989 Boss surveys (6) and file Act 74 in 1972.
P.12-19.

1989 Hughes survey P.18.