

**SURVEY &  
REMONUMENTATION**

**FILED**

APR 28 1995

LAND CORNER RECORDATION CERTIFICATE  
Filing Requirement of Act 74, Mich. P.A. 1970

Nov 16 2 00 PM '94

NANCY HAVILAND  
REGISTER OF DEEDS  
LIVINGSTON COUNTY, MI  
48843

LIVINGSTON  
(County)

**COMMISSION**

Located In:

Corner Code ##

Public Land Survey	T <u>2N</u> R <u>3E</u>	<u>I-12</u>
	T _____ R _____	_____
	T _____ R _____	_____
	T _____ R _____	_____
Property Controlling in Section	S _____ T _____ R _____	_____
	S _____ T _____ R _____	_____
Miscellaneous Property in Sec.	S _____ T _____ R _____	_____
	S _____ T _____ R _____	_____

L.S.C.#331m

Register of Deeds Stamp & File Number

Lot No. \_\_\_\_\_, Recorded Plat \_\_\_\_\_  
Private Claims \_\_\_\_\_

	A	B	C	D	E	F	G	H	I	J	K	L	M
2	6	5	4	3	2	1							
3													
4	7	8	9	10	11	12							
5													
6	18	17	16	15	14	13							
7													
8	19	20	21	22	23	24							
9													
10	30	29	28	27	26	25							
11													
12	31	32	33	34	35	36							
13													

IOSCO TWP.

DARRELL HUGHES in a field survey on NOVEMBER 2, 1994,  
hereby certify that under requirements of P.A. 74, Michigan P.A. of 1970, the corner points mentioned in lines 1 and 2 above were in conformance with regulations and rules therefore as required in the current manual of survey instructions of the United States Department of the Interior, Bureau of Land Management or by a decree of a Court of Law and/or that the corner points mentioned in lines 3, 4 and 5 above were in conformance with the rules of the Michigan Board of Land Surveyors or by a Decree of a Court of Law; established, re-established, monumented, re-monumented, recovered, found as expressed below:

**NOTE: Not more than 4 corners, all in the same town and range, may be recorded on this certificate.**

Description of original monument and accessories and/or subsequent restoration:

GLO: 1825 Sylvester Sibley, Deputy Surveyor  
White Oak 13" South 57 degrees West 22 links  
Black Oak 14" North 45 degrees East 52 links


\*Additional historical information on back of sheet

Description of corner evidence found and/or method applied in restoring or reestablishing corner:

Fd. 1/2" iron rod 3 feet West of N/S fence

Description of monument for corner and accessories established to perpetuate locating the position of the corner:

I-12, T2N, R3E, IOSCO replaced existing corner with 1-1/4" X 36" iron pipe, affixed with 2" dia. brass disk. Disk stamped "Livingston Co. Monumentation Corner, 19834" and is accepted as a careful and faithful reestablishment of the position of the original corner.  
095 DEG. 60.5' TO CENTERLINE OF WINDMILL.  
292 DEG. 7.74' SET NAIL/TAG S/S 12" ELM.  
351 DEG. 23.11' SET NAIL/TAG W/S 21" ELM.  
104 DEG. 1.77' SET NAIL/TAG S/S TWIN 12" ELM.  
159 DEG. 57.87' SET NAIL/TAG SW/S 10" WALNUT.

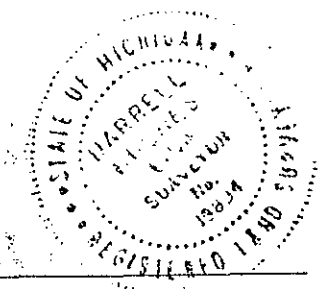

Signed by Darrell Hughes

Date November 3, 1994

Surveyor's Michigan License No. 19834

FORM APPROVED BY MICHIGAN STATE BOARD OF LAND SURVEYORS, JAN. 28, 1971  
REVISED MAY 14, 1975  
REVISED JAN., 1983

P.A. 345 1993, APPROVED BY LIVINGSTON COUNTY  
RECORD GROUP ON 3 Aug 94 CO. REP [Signature]

IOSCO TOWNSHIP, T2N, R3E

I-12, WEST 1/4 COR. SEC.35 & EAST 1/4 COR. SEC. 34.

FIELD 02-22-1994 D.D.HUGHES AND ASSOCIATES, FOWLerville.

Found 1/2" iron rod, 3' West of N/S fence and 45.5' North of North gate post of same fence. Witness' check to Boss. Poor for GPS. tree row to West, fencing N/S. Could not determine who set 1/2" rod. I-12 to H-12, Boss 2656.80' P.14, Hughes 2656.99'; I-12 to I-11, Boss 2624.76' P.14, Hughes 2626.18' P.19.

1825 Sylvester Sibley set 1/4 post at 40 chains.P.07

1872 Miles Bullock divided all of Section 34, P. 08-08A. 40.02 Chains to I-11 (2641.32'). 40.43 chains to H-12 (2668.38').

1966 Lyle Munsell uses corner is survey. P.09, Witness card P.10.

1972 Boss files Act 74, fd. 1/2" iron. P.11.

1972 Garlock performs survey P.12, and files Act 74, P.13, using 1967 witness'.

1973-1983 Boss surveys (4) P.14-18 use corner.

1989-1993 Hughes surveys P.19 &21.