

**SURVEY &
REMONUMENTATION**

FILED

APR 28 1995

LAND CORNER RECORDATION CERTIFICATE
Filing Requirement of Act 74, Mich. P.A. 1970

NOV 16 2 00 PM '94

COMMISSION

NANCY HAVILAND
REGISTER OF DEEDS
LIVINGSTON COUNTY, MI
48843

L.S.C. #332^m
Register of Deeds Stamp & File Number

For corners in

LIVINGSTON
(County)

Located In:

Corner Code ##

- | | | |
|------------------------------------|-------------------------|-------------|
| 1. Public Land Survey | T <u>2N</u> R <u>3E</u> | <u>I-13</u> |
| | T _____ R _____ | _____ |
| | T _____ R _____ | _____ |
| | T _____ R _____ | _____ |
| 2. Property Controlling in Section | S _____ T _____ R _____ | _____ |
| | S _____ T _____ R _____ | _____ |
| 3. Miscellaneous Property in Sec. | S _____ T _____ R _____ | _____ |
| | S _____ T _____ R _____ | _____ |

4. Lot No. _____, Recorded Plat _____
5. Private Claims _____

DARRELL HUGHES, in a field survey on NOVEMBER 2, 19 94

I hereby certify that under requirements of P.A. 74, Michigan P.A. of 1970, the corner points mentioned in lines 1 and 2 above were in conformance with regulations and rules therefore as required in the current manual of survey instructions of the United States Department of the Interior, Bureau of Land Management or by a decree of a Court of Law and/or that the corner points mentioned in lines 3, 4 and 5 above were in conformance with the rules of the Michigan Board of Land Surveyors or by a Decree of a Court of Law; established, re-established, monumented, re-monumented, recovered, found as expressed below:

NOTE: Not more than 4 corners, all in the same town and range, may be recorded on this certificate.

Description of original monument and accessories and/or subsequent restoration:

GLO: 1825 Sylvester Sibley, Deputy Surveyor
Tamarack 7" North 73 degrees West 34½ links
Tamarack 7" North 60 degrees East 29 links

*Additional historical information on back of sheet

Description of corner evidence found and/or method applied in restoring or reestablishing corner:


Fd. 3/4" iron pipe

	A	B	C	D	E	F	G	H	I	J	K	L	M
2	6	5	4	3	2	1							
3													
4	7	8	9	10	11	12							
5													
6	18	17	16	15	14	13							
7													
8	19	20	21	22	23	24							
9													
10	30	29	28	27	26	25							
11													
12	31	32	33	34	35	36							
13													

IOSCO TWP.

Description of monument for corner and accessories established to perpetuate locating the position of the corner:

I-13, T2N, R3E, IOSCO, replaced existing corner with 1-1/4" X 36" iron pipe, affixed with 2" dia. brass disk. Disk stamped "Livingston Co. Monumentation Corner, 19834" and is accepted as a careful and faithful reestablishment of the position of the original corner.
056 DEG. 41.30' SET NAIL/TAG SW/S 13" MAPLE.
326 DEG. 72.30' SET NAIL/TAG NE/S 16" WALNUT.
292 DEG. 37.54' SET NAIL/TAG E/S 16" MAPLE.
275 DEG. 86.30' FD. 1" IRON PIPE FOR I-1, T1N, R3E.

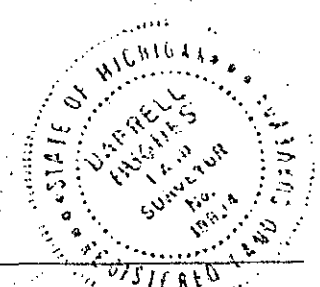

Drawn by Darrell Hughes Date November 3, 1994

Surveyor's Michigan License No. 19834

FORM APPROVED BY MICHIGAN STATE BOARD OF LAND SURVEYORS, JAN. 28, 1971
REVISED MAY 14, 1975
REVISED JAN., 1983

PA. 345 1960, APPROVED BY LIVINGSTON COUNTY
3 Aug 94 CO. REC. Robb

IOSCO TOWNSHIP, T2N, R3E

I-13, SW CORNER SEC. 35, SE CORNER SEC. 34.

FIELD 02-22-1994 D.D.HUGHES AND ASSOCIATES, FOWLerville

Found 3/4" iron pipe in low swampy area, old wire W,N and East. Fd. 1-1/4" iron pipe 86.38' West for I-1, Unadilla. Point falls in Maple swamp, not good for GPS. Witness' check close to Boss P.11B, and Wilson P.9A.

1825 Sylvester Sibley, Deputy U.S. Surveyor, sets corner post "in Tamarack swamp, very thickety" P.07

1825 Sibley intersects Township line 152 links (100.32') West of I-13 P.07A. Now 86.38'.

1872 Miles Bullock divides all of Section 34 (P.8-8A) I-13 to H-13 40.16 chains (2650.56'), Boss 2648.60' P.11, Wilson 2649.15' P.09, Hughes (not measured)., GLO 2640'.

100 YEARS LATER.....

1972 Wilson performs survey P.9-9B, files Act 74 for I-13, Iosco and I-01, Unadilla. Wilson set both corners.

1973, 1983, 1988 Boss surveys use and tie in I-13 and I-1 Unadilla.