

**SURVEY &  
REMONUMENTATION**

**FILED**

**APR 28 1995 LAND CORNER RECORDATION CERTIFICATE**  
**COMMISSION Filing Requirement of Act 74, Mich. P.A. 1970**

**Nov 16 2 00 PM '94**

**NANCY HAVILAND  
REGISTER OF DEEDS  
LIVINGSTON COUNTY, MI  
48843**

**L.S.C.#333m  
Register of Deeds Stamp & File Number**

For corners in LIVINGSTON (County) Located In: Corner Code J-11

1. Public Land Survey	T <u>2N</u> R <u>3E</u>	<u>J-11</u>
	T _____ R _____	_____
	T _____ R _____	_____
	T _____ R _____	_____
2. Property Controlling in Section	S _____ T _____ R _____	_____
	S _____ T _____ R _____	_____
3. Miscellaneous Property in Sec.	S _____ T _____ R _____	_____
	S _____ T _____ R _____	_____

4. Lot No. \_\_\_\_\_, Recorded Plat \_\_\_\_\_  
5. Private Claims \_\_\_\_\_

	A	B	C	D	E	F	G	H	I	J	K	L	M
2	6		5		4		3		2		1		
3													
4	7		8		9		10		11		12		
5													
6	18		17		16		15		14		13		
7													
8	19		20		21		22		23		24		
9													
10	30		29		28		27		26		25		
11													
12	31		32		33		34		35		36		
13													

**IOSCO TWP.**

DARRELL HUGHES, in a field survey on NOVEMBER 2, 19 94,  
do hereby certify that under requirements of P.A. 74, Michigan P.A. of 1970, the corner points mentioned in lines 1 and 2 above were in conformance with regulations and rules therefore as required in the current manual of survey instructions of the United States Department of the Interior, Bureau of Land Management or by a decree of a Court of Law and/or that the corner points mentioned in lines 3, 4 and 5 above were in conformance with the rules of the Michigan Board of Land Surveyors or by a Decree of a Court of Law, established, re-established, monumented, re-monumented, recovered, found as expressed below:

**NOTE: Not more than 4 corners, all in the same town and range, may be recorded on this certificate.**

Description of original monument and accessories and/or subsequent restoration:

GLO: 1825 Sylvester Sibley, Deputy Surveyor  
White Oak 30" South 11½ degrees East 12 links  
White Oak 28" North 33 degrees East 42 links


\*Additional historical information on back of sheet

Description of corner evidence found and/or method applied in restoring or reestablishing corner:

Fd. 1/2" iron rod with cap #13574

Description of monument for corner and accessories established to perpetuate locating the position of the corner:

J-11, T2N, R3E, IOSCO, replaced existing corner with 1-1/4" X 36" iron pipe, affixed with 2" dia. brass disk. Disk stamped "Livingston Co. Monumentation Corner, 19834" and is accepted as a careful and faithful reestablishment of the position of the original corner.  
017 DEG. 18.14' SET NAIL/TAG W/S 16" TWIN BASSWOOD.  
064 DEG. 27.15' SET NAIL/TAG N/S 18" ELM.  
206 DEG. 40.27' SET NAIL/TAG E/S 24" MAPLE.  
251 DEG. 17.66' SET NAIL/TAG S/S 8" BASSWOOD.  
172 DEG. 125.8' CL N. FACE, N'LY (OF THREE) OIL STORAGE TANK.

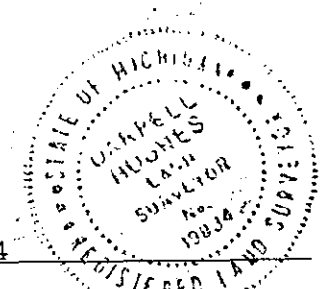

Signed by Darrell Hughes  
Surveyor's Michigan License No. 19834

Date November 3, 1994

FORM APPROVED BY MICHIGAN STATE BOARD OF LAND SURVEYORS, JAN. 28, 1971  
REVISED MAY 14, 1975  
REVISED JAN., 1983

**P.A. 345 1990, APPROVED BY LIVINGSTON COUNTY**

IOSCO TOWNSHIP, T2N, R3E

J-11, NORTH 1/4 CORNER SECTION 35

FIELD 11-29-1993 D.D.HUGHES AND ASSOCIATES, FOWLerville

Found 1/2" iron rod with Boss (13574) cap in old road bed north and south. Measures to 1/2 mile corners West and South agree with other surveyors. Corner is in treed area. No occupation East and West. Of interest: In 1872, M.W. Bullock measured East from J-11 to this corner, "in the dark" with a distance of 2650.56' (40.16 chains). Hughes 2652.81'. P.8A and P.30. Boss 2652.85' P.28.

1825 Sylvester Sibley, Deputy U.S. Surveyor, sets 1/4 post. P.7

1872 Miles Bullock divided all of Section 34 and NE part of 35 (P.8-8A)

1965 Lyle Munsell survey P.9 J-11 to J-12 Munsell 2639.22, Boss 2634.90 P.23, Hughes 2634.81' P.30, Garlock 2636.45' P.14, Benton 2634.76' P.19.

1969 Garlock survey P10-11

1972-1991 Boss surveys (12) showing corner.

1972 Garlock and Boss file Act 74 (5 days apart) measures differ slightly to same trees. P15-16

1989, 1992 and 1993 Hughes surveys use corner P.27,29,30.

1993 Hughes uses corner for computations in setting 1993 Liv. Co. Remonumentation corners K-11 and K-12. P32