

SURVEY & REMONUMENTATION

FILED

APR 28 1995 LAND CORNER RECORDATION CERTIFICATE **Nov 16 2 00 PM '94**

Filing Requirement of Act 74, Mich. P.A. 1970

NANCY HAVILAND
REGISTER OF DEEDS
LIVINGSTON COUNTY, MI
48843

COMMISSION

For corners in	Located In:	Corner Code #
LIVINGSTON (County)		
1. Public Land Survey	T <u>2N</u> R <u>3E</u>	<u>J-13</u>
	T _____ R _____	_____
	T _____ R _____	_____
	T _____ R _____	_____
2. Property Controlling in Section	S _____ T _____ R _____	_____
	S _____ T _____ R _____	_____
3. Miscellaneous Property in Sec.	S _____ T _____ R _____	_____
	S _____ T _____ R _____	_____
4. Lot No. _____, Recorded Plat _____		
5. Private Claims _____		

L.S.C.#334m
Register of Deeds Stamp & File Number

DARRELL HUGHES, in a field survey on NOVEMBER 2, 19 94,
do hereby certify that under requirements of P.A. 74, Michigan P.A. of 1970, the corner points mentioned
in lines 1 and 2 above were in conformance with regulations and rules therefore as required in the
current manual of survey instructions of the United States Department of the Interior, Bureau of Land
Management or by a decree of a Court of Law and/or that the corner points mentioned in lines 3, 4 and 5
above were in conformance with the rules of the Michigan Board of Land Surveyors or by a Decree of a
Court of Law; established, re-established, monumented, re-monumented, recovered, found as
expressed below:

NOTE: Not more than 4 corners, all in the same town and range, may be recorded on this certificate.

	A	B	C	D	E	F	G	H	I	J	K	L	M
2	6	5	4	3	2	1							
3													
4	7	8	9	10	11	12							
5													
6	13	17	16	15	14	13							
7													
8	19	20	21	22	23	24							
9													
10	30	29	28	27	26	25							
11													
12	31	32	33	34	35	36							
13													


IOSCO TWP.

A. Description of original monument and accessories and/or subsequent restoration:
GLO: 1825 Sylvester Sibley, Deputy Surveyor
White Oak 9" North 47½ degrees West 38 links
White Oak 12" North 44 degrees East 30 links

*Additional historical information on back of sheet

B. Description of corner evidence found and/or method applied in restoring or reestablishing corner:
Fd. 3/4" iron pipe

C. Description of monument for corner and accessories established to perpetuate locating the position of the corner:
J-13, T2N, R3E, IOSCO, replaced existing corner with 1-1/4" X 36" iron pipe, affixed with 2" dia. brass disk. Disk stamped "Livingston Co. Monumentation Corner, 19834" and is accepted as a careful and faithful reestablishment of the position of the original corner.
235 DEG. 37.20' SET NAIL/TAG NW/S 33" OAK.
305 DEG. 29.32' SET NAIL/TAG S/S 16" HICKORY.
331 DEG. 44.25' SET NAIL/TAG NE/S 18" OAK.
199 DEG. 169.52' SET NAIL/TAG SE/S 12" HICKORY.
270 DEG. 87.90' FD. 1-1/4" IRON PIPE FOR J-1, T1N, R3E.

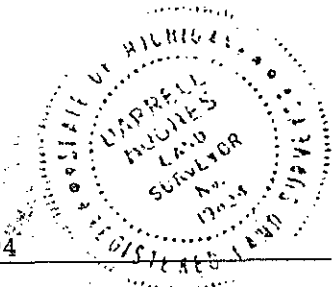

Signed by Darrell Hughes Date November 3, 1994
Surveyor's Michigan License No. 19834

IOSCO TOWNSHIP, T2N, R3E

J-13, SOUTH 1/4 CORNER SECTION 35

FIELD 11-29-1993 D.D.HUGHES AND ASSOCIATES, FOWLerville

Found 3/4" iron pipe 1.5' below grade. Location of point is at centerline of gravel road extended from the North. The centerline of said road curves to Southeast and intersects the E/W township line 45' west of this point. Found 1-1/4" iron pipe for North 1/4 corner Section 2, T1N, R3E, J-1, west 87.93'. Distances measured North and East to 1/2 mile corners check close to measures by other surveyors. (Boss, Garlock, Wilson). Fence row to west, cl road to north, no occupation to east. Corner falls in open area. Good for future GPS.

1825 Sylvester Sibley, Deputy U.S. Surveyor, sets 1/4 post. P.7

1965 Garlock witness card 3/4" X 16" Iron pipe. P.8 for survey P.9

1971 Garlock files Act 74, fd. same pipe set by Lyle Munsell in 1963.

1972 Wilson performs survey, finds same pipe, files Act 74. P.12-13

1973-1989 Boss performs 18+ surveys using same pipe. witness' on surveys check. P.14-31

1990 Hughes performs survey. P.32 found same pipe.

1993 Hughes uses corner for computations in setting 1993 Liv. Co. Remonumentation corners K-1 Unadilla and K-13, Iosco.