

**LAND CORNER RECORDATION CERTIFICATE**  
**Filing Requirement of Act 74, Mich. P.A. 1970**

For corners in

Livingston  
 (County)

Located In:

Corner Code #

- |                                    |                         |             |
|------------------------------------|-------------------------|-------------|
| 1. Public Land Survey              | T <u>2N</u> R <u>3E</u> | <u>K-11</u> |
|                                    | T _____ R _____         | _____       |
|                                    | T _____ R _____         | _____       |
|                                    | T _____ R _____         | _____       |
| 2. Property Controlling in Section | S _____ T _____ R _____ | _____       |
|                                    | S _____ T _____ R _____ | _____       |
| 3. Miscellaneous Property in Sec.  | S _____ T _____ R _____ | _____       |
|                                    | S _____ T _____ R _____ | _____       |

4. Lot No. \_\_\_\_\_, Recorded Plat \_\_\_\_\_  
 5. Private Claims \_\_\_\_\_

DEC 27 12 22 PM '93  
 NANCY HAVILAND  
 REGISTER OF DEEDS  
 LIVINGSTON COUNTY, MI  
 48843

FILED

L.S.C. #124m  
 Register of Deeds Stamp & File Number

I, Darrell D. Hughes, in a field survey on December 17, 1993, do hereby certify that under requirements of P.A. 74, Michigan P.A. of 1970, the corner points mentioned in lines 1 and 2 above were in conformance with regulations and rules therefore as required in the current manual of survey instructions of the United States Department of the Interior, Bureau of Land Management or by a decree of a Court of Law and/or that the corner points mentioned in lines 3, 4 and 5 above were in conformance with the rules of the Michigan Board of Land Surveyors or by a Decree of a Court of Law; established, re-established, monumented, re-monumented, recovered, found as expressed below:

**NOTE: Not more than 4 corners, all in the same town and range, may be recorded on this certificate.**

A. Description of original monument and accessories and/or subsequent restoration:

GLO: 1825.  
 Tamarack 9" N64E 33 lks.  
 Tamarack 8" S84W 26 lks.

	A	B	C	D	E	F	G	H	I	J	K	L	M
2	6	5	4	3	2	1							
3													
4	7	8	9	10	11	12							
5													
6	18	17	16	15	14	13							
7													
8	19	20	21	22	23	24							
9													
10	30	29	28	27	26	25							
11													
12	31	32	33	34	35	36							
13													

RECEIVED  
 RECORDS SECTION  
 1993  
 COMMISSION

\*Additional historical information on back of sheet:


B. Description of corner evidence found and/or method applied in restoring or reestablishing corner:

Physical corner not found.  
 Pro-rated measures of existing and computed co-ordinates of corners found and re-measured in Sections 35 & 36.

C. Description of monument for corner and accessories established to perpetuate locating the position of the corner:

K-11, T2N, R3E, IOSCO, set corner with 1-1/4" X 36" iron pipe, affixed with 2" dia. brass cap, stamped "Livingston Co. Monumentation Corner, P.S. 19834, 11' W. of cl n/s ditch, 12" below grade in W. bank of ditch and is accepted as a careful and faithful reestablishment of the position of the original corner.  
 044 DEG. 32.75' SET 1" IRON PIPE/BRASS WIT. DISK.  
 151 DEG. 36.13' SET 1" IRON PIPE/BRASS WIT. DISK.  
 180 DEG. 29.66' SET 1" IRON PIPE/BRASS WIT. DISK.  
 360 DEG/ 25.34' SET 1" IRON PIPE/BRASS WIT. DISK.

Signed by Darrell D. Hughes Date December 27, 1993  
 Surveyor's Michigan License No. 19834

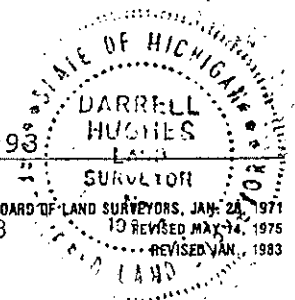

IOSCO TOWNSHIP, T2N, R3E

K-11, NORTHWEST CORNER SECTION 36

FIELD 10-27-1993 D.D.HUGHES AND ASSOCIATES, FOWLerville

Corner not found. Location falls in active farm field. Corner is obliterated but not lost. The corner will be established by retracement of surveys by others.

1825, corner first set by Sylvester Sibley, Deputy U.S. Surveyor, " in Tamarack swamp".

1861, E.N.Fairchilds, County Surveyor, divided Section 36.

1936, Clay Gordon shows corner with 40.20 chains East to N1/4 corner.

1965, Lyle Munsell, shows straight line for West line of Section 36, and 2640 West to N1/4 corner Section 35.

1976, Boss ran extensive traverse for all of Section 36 and into the East 1/2 of Section 35. This corner shown to be calculated.

1978, Boss shows corner calculated Job no. 10484, L.904, P.214.

Corner to be set, based on Boss (1976) section break-down.