


MISC. CORNERS -
MARK + NUMBER

MARION TWP.
T2N , R4E

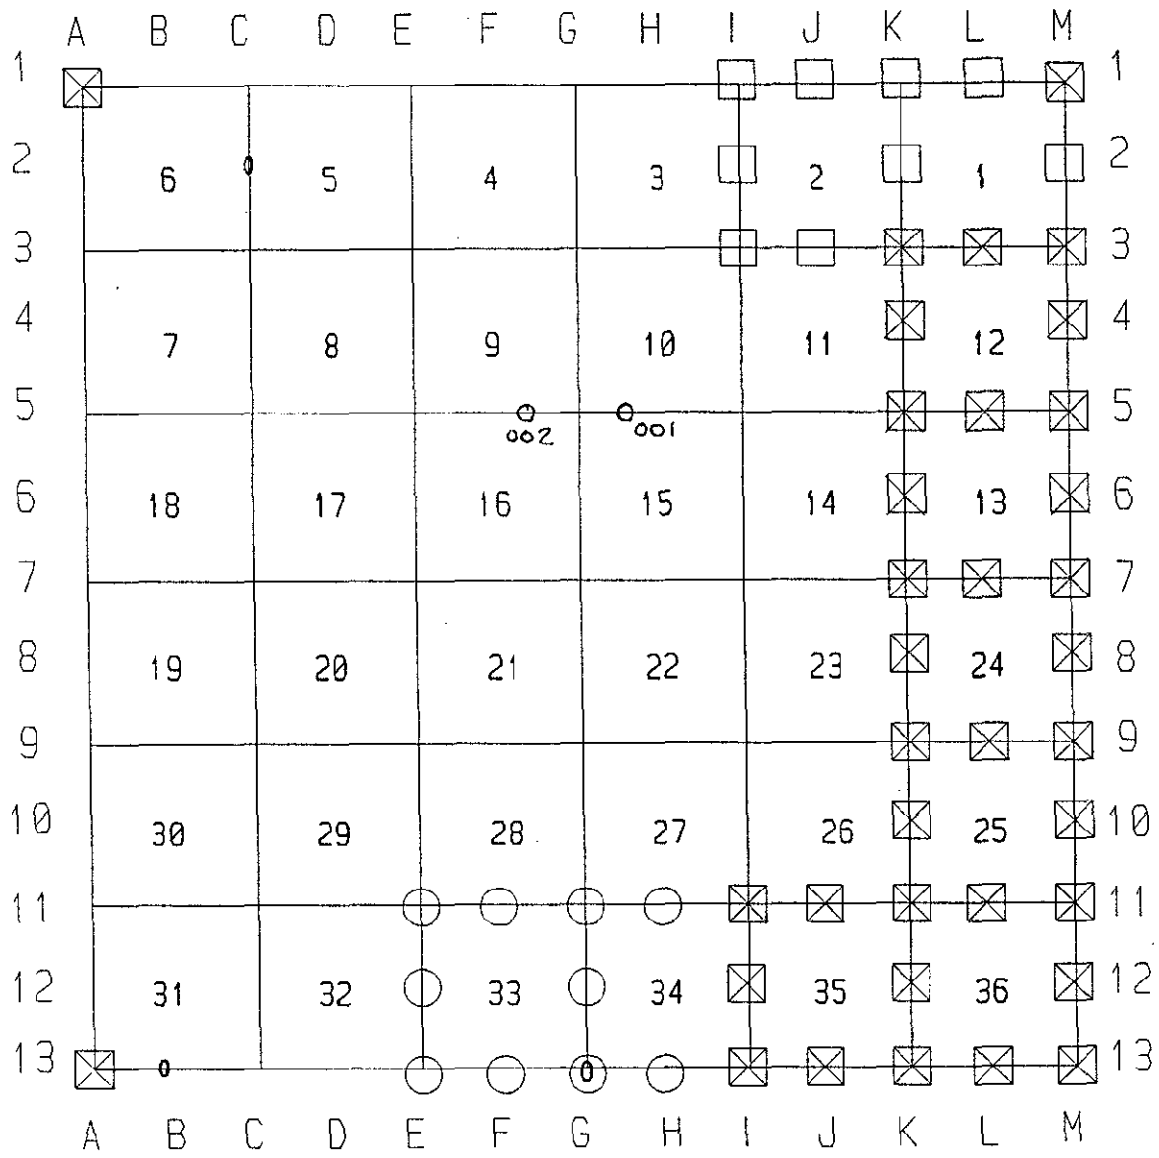

LEGEND

SURVEY &
REMONUMENTATION

FEB 22 1999

SECTION

- ☒ CORNERS COMPLETED TO DATE
- 1996 PROPOSED CORNERS
- 1997 PROPOSED CORNERS
- DOUBLE/PROBLEM CORNERS

001 LSC 900/871
002 LSC 900 872
Alpha IV entry ↑

PREPARED BY: LIVINGSTON COUNTY EQUALIZATION DEPT. 3/96