

LAND CORNER RECORDATION CERTIFICATE
 Filing Requirement of Act 74, Mich. P.A. 1970

FILED

For corners in

LIVINGSTON
 (County)

Located In:

Corner Code #

9-

1997 AUG 19 A 10: 03

NANCY HAVILAND
 REGISTER OF DEEDS
 LIVINGSTON COUNTY, MI.
 48843

1. Public Land Survey

T 2N R 4E B-13
 T R _____
 T R _____
 T R _____

2. Property Controlling in Section

S T R _____
 S T R _____
 S T R _____
 S T R _____

3. Miscellaneous Property in Sec.

L.S.C.#683m

Register of Deeds Stamp & File Number

4. Lot No. _____, Recorded Plat _____
 5. Private Claims _____

CHARLES E GARLOCK, in a field survey on MAY 21, 1997 do hereby state that under requirements of P.A. 74, Michigan P.A. of 1970, the corner points mentioned in lines 1 and 2 above were in conformance with regulations and rules therefore as required in the current manual of survey instructions of the United States Department of the Interior, Bureau of Land Management or by a decree of a Court of Law and/or that the corner points mentioned in lines 3, 4 and 5 above were in conformance with the rules of the Michigan Board of Land Surveyors or by a Decree of a Court of Law, established, re-established, monumented, recovered, found as expressed below:

NOTE: Not more than 2 corners, all in the same town and range, may be recorded on this certificate.

	A	B	C	D	E	F	G	H	I	J	K	L	M
1													
2	6		5		4		3		2		1		
3													
4	7		8		9		10		11		12		
5													
6	18		17		16		15		14		13		
7													
8	19		20		21		22		23		24		
9													
10	30		29		28		27		26		25		
11													
12	31		32		33		34		35		36		
13													

A. Description of original monument and accessories and/or subsequent restoration:
 GLO SURVEY DATED APRIL 15, 1825 BY S SIBLEY AND NONE OF THE GLO WITNESSES REMAIN
 GLO WITNESSES: WD 14-N68E-29 LKS
 WD 16-N69 1/2W-43 LKS

ADDITIONAL DATA ON REAR OF SHEET

B. Description of corner evidence found and/or method applied in restoring or reestablishing corner:
 FD. 3/4" I. ROD 2N E Y OF PINGREEE ROAD AND EAST 7.99 FT. FOUND T1N-R4E COR. ON SECTION LINE.
 TO C/L OF

**SURVEY &
 REMONUMENTATION**


FEB 24 1998

SECTION

C. Description of monument for corner and accessories established to perpetuate locating the position of the corner:
 B-13: S 1/4 COR. SEC. 31 T2N-R4E, MARION TWP. LIV. CO. MI, RESET ABOVE WITH 1 1/4" X 36" BREAK-AWAY I. PIPE WITH LIV. CO. REMON BRASS CAP ON TOP AT -0.5'
 S84E-200.62'-SP & TAG S/S U POLE
 S56E-85.89'-SP & TAG N/S 30" OAK
 S17W-152.96'-SP & TAG E/S 42" OAK
 N12W-85.55'-SP & TAG E/S 5" ELM
 S88E-29.89'-FACE OF ST. SIGN POST
 EAST-2'-CTR. N-S ROAD
 SOUTH-23'-CTR. OF ROAD TO THE EAST
 EAST-7.99'-T1N-R4E CORNER FOUND ON SOUTH SECTION LINE

Signed by Charles E. Garlock
 Surveyor's Michigan License No. 14762

Date MAY 27, 1997

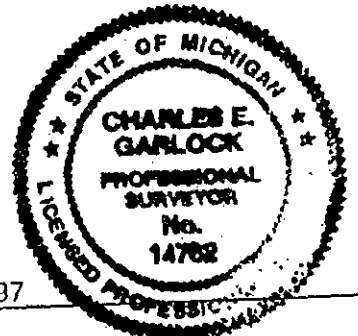

P.A. 345 1990, APPROVED BY LIVINGSTON COUNTY
 PEER GROUP ON 2/26/97 CO. REP JED

"Be Sure of Your Ground"

CHARLES E. GARLOCK

PROFESSIONAL SURVEYOR

705 N. MICHIGAN AVE.
HOWELL, MICHIGAN 48843

OFFICE: (517) 546-3340

FAX: 517 546-2041

FEBRUARY 18, 1997

CORNER SUMMARY

B-13: SOUTH 1/4 COR. SEC. 31 MARION TWP. LIV. CO. MI

GLO SURVEY DATED APRIL 15, 1825 BY S SIBLEY AND NONE OF THE GLO WITNESSES REMAIN.


BULLOCK'S 1895 WITNESS IS GONE.

BENTON IN 1976 FOUND A SPIKE ON THE NORTH EDGE OF SCHAFER ROAD AND ON THE CENTERLINE OF PINGREE ROAD TO THE NORTH AND SET A 3/4" IRON ROD, NONE OF HIS WITNESSES REMAIN, BUT HIS DISTANCES NORTH, EAST AND WEST CHECK WITH OTHER SURVEYORS. HUGHES WITNESSES WERE FOUND AND THEY CHECK WITH THE BENTON IRON, WE ALSO FOUND THE PUTNAM TWP. CORNER 7.99 TO THE EAST AND ON THE SOUTH TOWNSHIP LINE, GLO COMPS AT 2.64 EAST. MEASURES WEST ARE: 2485.52=BENTON '78, 2485.56=BOSS '89 AND GLO IS 2485.56; NORTH ARE 2600.39 = BENTON, HUGHES AND GARLOCK; EAST ARE 2610.96=FAIRCHILD 1851, 2649.68=BENTON '84, 2649.53=GARLOCK '96, 2649.55=HUGHES '95 AND WE HAD 2649.53 IN '97. IRON IS LOCATED IN A GRAVEL ROAD INTERSECTION AND A GOOD GPS SITE. WE RECOMMEND THE FOUND BENTON IRON AS THE TRUE B-13

CHARLES E GARLOCK
PS 14762
MAR97B13

SUCCESSOR TO:

- MILES W. BULLOCK, L.S. (1844 TO 1926) ● GRANT H DUNNING, P.E. (1865 TO 1928)
- CLAY W. GORDON, RLS (1883 TO 1970) ● LYLE W. MUNSELL, RLS (1904 TO 1987)

 

ZNAE B13 4