

9-

LAND CORNER RECORDATION CERTIFICATE  
Filing Requirement of Act 74, Mich. P.A. 1970

FILED

For corners in

LIVINGSTON  
(County)

Located In:

Corner Code #

1. Public Land Survey

T 2N R 4E D-13  
T \_\_\_\_\_ R \_\_\_\_\_  
T \_\_\_\_\_ R \_\_\_\_\_  
T \_\_\_\_\_ R \_\_\_\_\_

2. Property Controlling in Section

S \_\_\_\_\_ T \_\_\_\_\_ R \_\_\_\_\_  
S \_\_\_\_\_ T \_\_\_\_\_ R \_\_\_\_\_

3. Miscellaneous Property in Sec.

S \_\_\_\_\_ T \_\_\_\_\_ R \_\_\_\_\_  
S \_\_\_\_\_ T \_\_\_\_\_ R \_\_\_\_\_

4. Lot No. \_\_\_\_\_, Recorded Plat \_\_\_\_\_  
5. Private Claims \_\_\_\_\_

1997 AUG 19 A 10:03

NANCY HAVILAND  
REGISTER OF DEEDS  
LIVINGSTON COUNTY, MI.  
48843

L.S.C.# 685m

Register of Deeds Stamp & File Number

I, CHARLES E. GARLOCK, in a field survey on AUGUST 9, 1997 do hereby state that under requirements of P.A. 74, Michigan P.A. of 1970, the corner points mentioned in lines 1 and 2 above were in conformance with regulations and rules therefore as required in the current manual of survey instructions of the United States Department of the Interior, Bureau of Land Management or by a decree of a Court of Law and/or that the corner points mentioned in lines 3, 4 and 5 above were in conformance with the rules of the Michigan Board of Land Surveyors or by a Decree of a Court of Law; established, re-established, monumented, recovered, found as expressed below:

NOTE: Not more than 2 corners, all in the same town and range, may be recorded on this certificate.

	A	B	C	D	E	F	G	H	I	J	K	L	M
1													
2	6		5		4		3		2		1		
3													
4	7		8		9		10		11		12		
5													
6	18		17		16		15		14		13		
7													
8	19		20		21		22		23		24		
9													
10	30		29		28		27		26		25		
11													
12	31		32		33		34		35		36		
13													

A. Description of original monument and accessories and/or subsequent restoration:

GLO SURVEY DATED APRIL 15, 1825 BY S SIBLEY AND NONE OF THE GLO WITNESSES REMAIN  
GLO WITNESSES: WO 5-N32E-133 LKS  
BO 9-N88W-120 LKS

B. Description of corner evidence found and/or method applied in restoring or reestablishing corner:

FOUND 1/2" IRON ROD IN ROAD INTERSECTION THAT CHECKED WITH M BULLOCK 1877 WITNESS TREE AND FOUND T1N-R4E CORNER 10.29' EAST AND 0.17' SOUTH OF THE SECTION LINE.

**SURVEY &  
REMONUMENTATION**

**FEB 24 1998**


**SECTION**

C. Description of monument for corner and accessories established to perpetuate locating the position of the corner:

D-13: S 1/4 COR. SEC. 32 T2N-R4E, MARION TWP. LIV. CO. MI., RESET POINT WITH 1 1/4" X 36" BREAKAWAY IRON PIPE WITH LIV. CO. REMON BRASS CAP ON TOP AT -0.5'  
S45W-33.98'-SP & TAG NW/S 50" OAK (BULLOCK TREE)  
N69E-58.42'-SP & TAG S/S 14" WALNUT  
N76E-93.57'-SP 7 TAG S/S 48" OAK  
S72E-111.82'-NW COR. BARN  
EAST-7'-C/L HINCHEY RD.  
SOUTH-4'-C/L SCHAFER RD.  
EAST-10.29'-T1N-R4E COR.

Signed by Charles E. Garlock  
Surveyor's Michigan License No. 14762

Date AUGUST 10, 1997

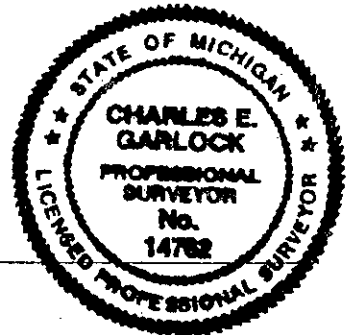

Take Care of your Ground  
CHARLES E. GARLOCK

PROFESSIONAL SURVEYOR

705 N. MICHIGAN AVE.

HOWELL, MICHIGAN 48843

OFFICE: (517) 546-3340

FAX: 517 546-2941

FEBRUARY 18, 1997

## CORNER SUMMARY

D-13: SOUTH 1/4 COR. SEC. 32 T2N-R4E MARION TWP. LIV. CO. MI

GLO SURVEY DATED APRIL 15, 1825 BY S SIBLEY AND NONE OF THE GLO WITNESSES REMAIN.

IN 1877 BULLOCK WITNESSED THE N 1/4 COR. SECTION 5 PUTNAM AT A POINT 10.2' EAST OF D-13 MARION (GLO IS 4.95' WEST) AND IT HAS BEEN USED THE SAME SINCE. WE FOUND D-1 PUTNAM 10.21' EAST OF D-13 MARION AND BULLOCKS WITNESS TO A NOW 48" OAK FROM D-1 CHECKED. WE FOUND THAT ALL REMAINING WITNESSES TO D-13 BY: BOSS '72, '84, '87 & '90, EASON '72, BENTON '74 AND FINNEY '92 CHECKED. THEREFORE D-13 HAS BEEN ACCEPTED, IN ITS PRESENT POSITION, SINCE 1877. MEASURES WEST ARE: 2659.76 = BENTON '74, 2659.37 = BENTON '84 AND 2659.40 = GARLOCK '96 & '97. MEASURES EAST ARE: 2642.65 = STREBBING '72, 2641.97 = BENTON '73 & '78 (BOTH TO 1/2" I. ROD) AND WE HAD 2647.42 TO A FOUND 1 1/4" I. PIPE BY DUNNING IN 1912. WE HAD 2641.48 TO THEIR 1/2" I. ROD. CORNER IS IN A GRAVEL ROAD INTERSECTION AND MARGINAL FOR GPS. WE RECOMMEND CONTINUED USE OF D-13 AS FOUND.



CHARLES E GARLOCK

PS 14762

MAR97D13

### SUCCESSOR TO:

MILES W. BULLOCK, L.S. (1844 TO 1928)



GRANT H DUNNING, P.E. (1865 TO 1928)

CLAY W. GORDON, RLS (1883 TO 1970)



LYLE W. MUNSELL, RLS (1904 TO 1987)