

FEB 24 1998

9-

SECTION

LAND CORNER RECORDATION CERTIFICATE
Filing Requirement of Act 74, Mich. P.A. 1970

FILED

For corners in

LIVINGSTON

(County)

Located In:

Corner Code #

1. Public Land Survey

T 2N R 4E

F-13

T R

T R

T R

T R

2. Property Controlling in Section

S T R

S T R

3. Miscellaneous Property in Sec.

S T R

S T R

1997 AUG 19 A 10:03

NANCY HAVILAND
REGISTER OF DEEDS
LIVINGSTON COUNTY, MI.
48843

L.S.C.#687m

Register of Deeds Stamp & File Number

4. Lot No. _____, Recorded Plat _____

5. Private Claims _____

I, CHARLES E GARLOCK, in a field survey on AUGUST 9, 1997 do hereby state that under requirements of P.A. 74, Michigan P.A. of 1970, the corner points mentioned in lines 1 and 2 above were in conformance with regulations and rules therefore as required in the current manual of survey instructions of the United States Department of the Interior, Bureau of Land Management or by a decree of a Court of Law and/or that the corner points mentioned in lines 3, 4 and 5 above were in conformance with the rules of the Michigan Board of Land Surveyors or by a Decree of a Court of Law; established, re-established, monumented, recovered, found as expressed below:

NOTE: Not more than 2 corners, all in the same town and range, may be recorded on this certificate.

1	A	B	C	D	E	F	G	H	I	J	K	L	M
2		6		5		4		3		2		1	
3													
4		7		8		9		10		11		12	
5													
6		18		17		16		15		14		13	
7													
8		19		20		21		22		23		24	
9													
10		30		29		28		27		26		25	
11													
12		31		32		33		34		35		36	
13													


A. Description of original monument and accessories and/or subsequent restoration:
GLO SURVEY DATED APRIL 15, 1825 BY S SIBLEY AND NONE OF THE GLO WITNESSES REMAIN.
GLO WITNESSES: BO 5-N 1 1/2E-23 LKS
BO 15-N79W-154 LKS

B. Description of corner evidence found and/or method applied in restoring or reestablishing corner:
FD. 1 1/4" THICK WALL GAS PIPE AS PER GH DUNNING 1912 WITNESSES ON THE NORTH EDGE OF GRAVEL ROAD CURVING TO THE SW'LY, TOP OF PIPE THAT WAS 48" LONG WAS BENT BADLY.

C. Description of monument for corner and accessories established to perpetuate locating the position of the corner:
F-13: S 1/4 COR. SEC. 33 T2N-R4E, MARION TWP. LIV. CO. MI. RESET FOUND POINT WITH 1 1/4" X 36" BREAKAWAY I. PIPE WITH LIV. REMON BRASS CAP ON TOP AT -0.7'
N47W-26.18'-SP & TAG N/S 6" WALNUT
N81W-56.04'-SP & TAG S/S 24" WALNUT
S38W-51.75'-SP & TAG W/S 18" HICKORY
N44E-27.47'-SP & TAG E/S 36" OAK (GH DUNNING TREE)
EAST-13.41'-FD. T1N-R4E COR. ON SOUTH LINE OF SECTION
SOUTH-16'-C/L ROAD CURVING SW'LY

Signed by Charles E. Garlock
Surveyor's Michigan License No. 14762


Date AUGUST 9, 1997

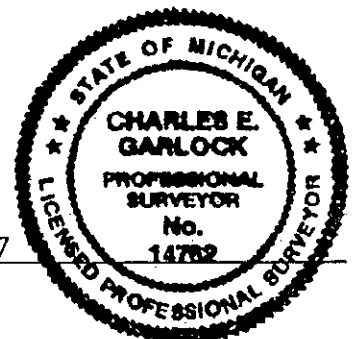


PROFESSIONAL SURVEYOR
705 N. MICHIGAN AVE.
HOWELL, MICHIGAN 48843
OFFICE: (517) 546-3340
FAX: 517 546-2941

FEBRUARY 19, 1997

 

CORNER SUMMARY

F-13: S 1/4 COR. SEC. 33 T2N-R4E, MARION TWP. LIV. CO. MI

GLO SURVEY DATED APRIL 15, 1825 BY S SIBLEY AND NONE OF THE GLO WITNESSES REMAIN.

BULLOCKS 1878 AND 1902 WITNESS TREES ARE GONE. DUNNINGS 1912 WITNESSES TO 3 TREES REMAIN AND THEY CHECK TO A FOUND 1 1/4" GAS PIPE AS DUNNING HAD DESCRIBED. BENTON IN '77 & '78 CALLED THE GAS PIPE A 1/2" IRON PIPE AS DID BOSS IN '87; BOTH SETS OF WITNESSES WERE TO THE SAME TREES AND DISTANCES THE SAME AND THEY INTERSECTED WITH THE FOUND 1 1/4" GAS PIPE LOCATED -0.6' AND ON THE NORTH EDGE OF THE GRAVEL ROAD IN A CURVE SW'LY. BRADYS WITNESSES HE CALLED F-13 ACTUALLY WERE TO PUTNAM TWPS. F-1; J SMITHS WITNESSES WERE TO ANOTHER CORNER, SOMEWHERE ??? AND D HUGHES WITNESSED F-1 OF PUTNAM TWP. FOR A JOB IN PUTNAM AND ALSO LISTED F-13 MARION AS BEING 13.30' WEST OF F-1. DUNNINGS GAS PIPE THAT WE FOUND LINED WITH A VERY OLD FENCE LINE AND HEDGE ROW TO THE NORTH, THE PUTNAM COR. F-1 WAS FOUND AND LOCATED ON THE SOUTH TWP. LINE EAST 13.41', BUT GLO JOG COMPUTES TO BE WEST 23.10'. BECAUSE OF OVERHANGING TREES THE SITE IS NOT SUITABLE FOR GPS. PREVIOUS SURVEYORS MEASURED WEST: 2651.88 = OLD RECORDS, 2651.22 = DUNNING '12, 2667.94 = MUNSELL '48 AND WE HAD 2644.03, MEASURED THIS TWICE AS A DOUBLE CHECK. MEASURES EAST ARE: 2651.88 = OLD RECORDS, 2650.56 = BENTON '68, 2650.46 = BENTON '77, 2650.04 = BOSS '87 & '91, 2650.02' = GARLOCK '96 AND WE HAD 2650.03. WE RECOMMEND THE CONTINUED USE OF DUNNINGS GAS PIPE AS FOUND FOR F-13.

Charles E. Garlock
CHARLES E GARLOCK
PS 14762
MAR97F13

2N4E F-13 4

SUCCESSOR TO:

- MILES W. BULLOCK, L.S. (1844 TO 1926) ● GRANT H DUNNING, P.E. (1865 TO 1928)
- CLAY W. GORDON, RLS (1889 TO 1970) ● LYLE W. MUNSELL, RLS (1904 TO 1987)