

SURVEY & REMONUMENTATION

FEB 25 1999

FILED

LAND CORNER RECORDATION CERTIFICATE
Filing Requirement of Act 74, Mich. P.A. 1970

SECTION

For corners in

LIVINGSTON
(County)

Located In:

Corner Code #

1. Public Land Survey

T 2N R 4E G6

T _____ R _____

T _____ R _____

T _____ R _____

2. Property Controlling in Section

S _____ T _____ R _____

S _____ T _____ R _____

3. Miscellaneous Property in Sec.

S _____ T _____ R _____

S _____ T _____ R _____

4. Lot No. _____, Recorded Plat _____

5. Private Claims _____

CHARLES E GARLOCK, in a field survey on AUG 11, 1998 do hereby state that under requirements of P.A. 74, Michigan P.A. of 1970, the corner points mentioned in lines 1 and 2 above were in conformance with regulations and rules therefore as required in the current manual of survey instructions of the United States Department of the Interior, Bureau of Land Management or by a decree of a Court of Law and for that the corner points mentioned in lines 3, 4 and 5 above were in conformance with the rules of the Michigan Board of Land Surveyors or by a Decree of a Court of Law; established, re-established, monumented, recovered, found as expressed below:

NOTE: Not more than 2 corners, all in the same town and range, may be recorded on this certificate.

A. Description of original monument and accessories and/or subsequent restoration:
GLO SURVEY DATED APRIL 15, 1825 BY S SIBLEY
GLO WITNESSES: TAM7-S28½W-17 LKS
TAM5-N59E-13 LKS

B. Description of corner evidence found and/or method applied in restoring or reestablishing corner:
FOUND 1/2" I. ROD 3.5 FT. EAST OF CENTERLINE OF COUNTY FARM ROAD (ASHPALT) AND LINES WITH OLD FENCE LINE REMAINS TO THE EAST AND WEST.

C. Description of monument for corner and accessories established to perpetuate locating the position of the corner:
G6: W 1/4 COR. SEC. 15, T2N-R4E, MARION TWP. LIV. CO. MI; REPLACED 1/2" I. ROD WITH MON. BOX AND 1 1/4" X 36" BREAKAWAY I. PIPE WITH LIV. CO. REMON BRASS CAP ON TOP.
WEST-31.40'-SP & TAG IN TOP OF WOOD FENCE POST
N40E-47.80'-S & TAG W/S 10" ELM
N80E64.41'-SP & TAG S/S 20" CHERRY
S40E-42.18'-SP & TAG W/S CTR. TREE OF 5-8" LOCUSTS


1998 AUG 20 P 4:47

NANCY HAVILAND
REGISTER OF DEEDS
LIVINGSTON COUNTY, MI.
48843

L.S.C. #899m

Register of Deeds Stamp & File Number

1	A	B	C	D	E	F	G	H	I	J	K	L	M
2		6		5		4		3		2		1	
3													
4		7		8		9		10		11		12	
5													
6		18		17		16	15	14		13			
7													
8		19		20		21		22		23		24	
9													
10		30		29		28		27		26		25	
11													
12		31		32		33		34		35		36	
13													

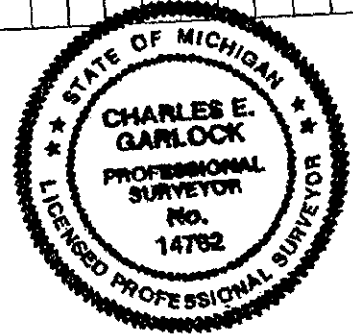

Signed by Charles E. Garlock
Surveyor's Michigan License No. 14762

Date AUGUST 12, 1998

P.A. 345 1990, APPROVED BY LIVINGSTON COUNTY
PEER GROUP ON 5/20/98, CO. REP JED

FORM APPROVED BY MICHIGAN STATE BOARD OF PROFESSIONAL SURVEYORS, JAN. 28, 1971
REVISED MAY 14, 1975
REVISED JAN., 1983
REVISED OCT., 1995