

**SURVEY & REMONUMENTATION**

FEB 25 1999

**SECTION**

**LAND CORNER RECORDATION CERTIFICATE**  
Filing Requirement of Act 74, Mich. P.A. 1970

**FILED**

For corners in  
LIVINGSTON

(County)

Located In:

Corner Code #

1. Public Land Survey

T	2N	R	4E	67
T		R		
T		R		
T		R		
S		T		
S		T		
S		T		
S		T		

2. Property Controlling  
in Section

3. Miscellaneous  
Property in Sec.

4. Lot No. \_\_\_\_\_, Recorded Plat \_\_\_\_\_  
5. Private Claims \_\_\_\_\_

I, CHARLES E GARLOCK, in a field survey on AUG 11, 1998 do hereby state that under requirements of P.A. 74, Michigan P.A. of 1970, the corner points mentioned in lines 1 and 2 above were in conformance with regulations and rules therefore as required in the current manual of survey instructions of the United States Department of the Interior, Bureau of Land Management or by a decree of a Court of Law and /or that the corner points mentioned in lines 3, 4 and 5 above were in conformance with the rules of the Michigan Board of Land Surveyors or by a Decree of a Court of Law; established, re-established, monumented, recovered, found as expressed below:

NOTE: Not more than 2 corners, all in the same town and range, may be recorded on this certificate.

A. Description of original monument and accessories and/or subsequent restoration:  
GLO SURVEY DATED APRIL 15, 1825 BY S SIBLEY  
GLO WITNESSES: B07-N52W-27 LKS  
W012-N72E-22 LKS

B. Description of corner evidence found and/or method applied in restoring or reestablishing corner:  
FOUND 5/8" I. ROD ABOUT 1 FT. EAST OF ASPHALT ROAD CENTERLINE AND LINES WITH CTR. OF DRIVE TO THE WEST AND HEDGE ROW TO THE EAST THAT BEGINS ABOUT 600 FT. EAST.


C. Description of monument for corner and accessories established to perpetuate locating the position of the corner:  
G7: SW COR. SEC. 15 T2N-R4E, MARION TWP. LIV. CO. MI.; REPLACED 5/8" I. ROD WITH MON BOX AND 1 1/4" X 36" BREAKAWAY I. PIPE WITH LIV. CO. REMON BRASS CAP ON TOP.  
S30W-57.83'-SP & TAG E/S DBL 14" OAKS  
S70W-56.69'-SP & TAG SE/S U. POLE  
N82W-94.22'-CHISLED "X" IN S/LY PART OF SOUTHEAST FLANGE BOLTS.  
EAST-15.00'-1" I. PIPE W/ REMON. WITNESS CAP NEXT TO A CARSONITE POST.

1998 AUG 20 P 4:46  
NANCY HAVILAND  
REGISTER OF DEEDS  
LIVINGSTON COUNTY, MI.  
48843

L.S.C. #898m

Register of Deeds Stamp & File Number

	A	B	C	D	E	F	G	H	I	J	K	L	M
1													
2	6		5		4		3		2		1		
3													
4	7		8		9		10		11		12		
5													
6	18		17		16		15		14		13		
7													
8	19		20		21		22		23		24		
9													
10	30		29		28		27		26		25		
11													
12	31		32		33		34		35		36		
13													

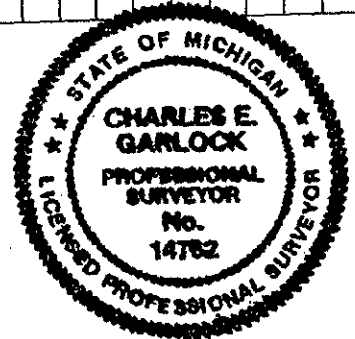

Signed by Charles E. Garlock  
Surveyor's Michigan License No. 14762

Date AUGUST 12, 1998

P.A. 345 1990, APPROVED BY LIVINGSTON COUNTY  
PEER GROUP ON 5/20/98 CO. REP JED