

SURVEY & REMONUMENTATION

FEB 24 1998

9-

LAND CORNER RECORDATION CERTIFICATE
Filing Requirement of Act 74, Mich. P.A. 1970

FILED

For corners in **SECTION**

| | | |
|------------------------------------|-------------|---------------|
| <u>LIVINGSTON</u> (County) | Located In: | Corner Code # |
| 1. Public Land Survey | T2N R 4E | H-13 |
| | T R | |
| | T R | |
| | T R | |
| 2. Property Controlling in Section | S T R | |
| | S T R | |
| 3. Miscellaneous Property in Sec. | S T R | |
| | S T R | |

1997 AUG 19 A 10:03
NANCY HAVILAND
REGISTER OF DEEDS
LIVINGSTON COUNTY, MI.
48843
L.S.C.#689m
Register of Deeds Stamp & File Number

4. Lot No. _____, Recorded Plat _____
5. Private Claims _____

| A | B | C | D | E | F | G | H | I | J | K | L | M |
|----|----|---|----|---|----|---|----|---|----|---|----|---|
| 1 | | | | | | | | | | | | |
| 2 | 6 | | 5 | | 4 | | 3 | | 2 | | 1 | |
| 3 | | | | | | | | | | | | |
| 4 | 7 | | 8 | | 9 | | 10 | | 11 | | 12 | |
| 5 | | | | | | | | | | | | |
| 6 | 18 | | 17 | | 16 | | 15 | | 14 | | 13 | |
| 7 | | | | | | | | | | | | |
| 8 | 19 | | 20 | | 21 | | 22 | | 23 | | 24 | |
| 9 | | | | | | | | | | | | |
| 10 | 30 | | 29 | | 28 | | 27 | | 26 | | 25 | |
| 11 | | | | | | | | | | | | |
| 12 | 31 | | 32 | | 33 | | 34 | | 35 | | 36 | |
| 13 | | | | | | | | | | | | |

I, CHARLES E GARLOCK, in a field survey on AUGUST 9, 1997 do hereby state that under requirements of P.A. 74, Michigan P.A. of 1970, the corner points mentioned in lines 1 and 2 above were in conformance with regulations and rules therefore as required in the current manual of survey instructions of the United States Department of the Interior, Bureau of Land Management or by a decree of a Court of Law and /or that the corner points mentioned in lines 3, 4 and 5 above were in conformance with the rules of the Michigan Board of Land Surveyors or by a Decree of a Court of Law; established, re-established, monumented, recovered, found as expressed below:

NOTE: Not more than 2 corners, all in the same town and range, may be recorded on this certificate.


A. Description of original monument and accessories and/or subsequent restoration:
GLO SURVEY DATED APRIL 15, 1825 BY S SIBLEY AND ONE OF HIS WITNESSES REMAIN.
GLO WITNESSES: BO 8-N76 1/2W-76 LKS (50.16') REMAINING WITNESS
BO 14- N30W-219 LKS

B. Description of corner evidence found and/or method applied in restoring or reestablishing corner:
FOUND NO MONUMENT, BUT A 1838 WITNESS BY FAIRCHILD INTERSECTED WITH A 1902 WITNESS BY BULLOCK NEAR THE C/L OF THE W.B. LANE OF SCHAFER ROAD AT A POINT THAT LINED WITH THE REMAINS OF AN OLD FENCE LINE TO THE NORTH, SET TEMP. PK SPIKE. FAIRCHILD WITNESS LATER FOUND TO BE A GLO WITNESS. FOUND T1N-R4E COR. TO BE 28.09' EAST ALONG SECTION LINE AND 5.29' SOUTH OF SECTION LINE.

C. Description of monument for corner and accessories established to perpetuate locating the position of the corner:
H-13: S 1/4 COR. SEC. 34 T2N-R4E, MARION TWP. LIV. CO. MI. RESET PK SPIKE WITH 1 1/4" X 36" BREAKAWAY I. PIPE WITH LIV. CO. REMON BRASS CAP ON TOP AT -0.5' IN A MON. BOX.
N62W-49.76'-SP & TAG S/S 44" DBL OAK
S64W-59.38'-SP & TAG NW/S 18" OAK
S30W-37.67'-SP & TAG W/S 24" OAK
S42E-49.34'-SP & TAG N/S 30" CHERRY
SOUTH-5'-C/L SCHAFER ROAD.
EAST-28.09' AND SOUTH 5.29'-TO T1N-R4E COR.

Signed by Charles E. Garlock
Surveyor's Michigan License No. 14762

Date AUGUST 10, 1997

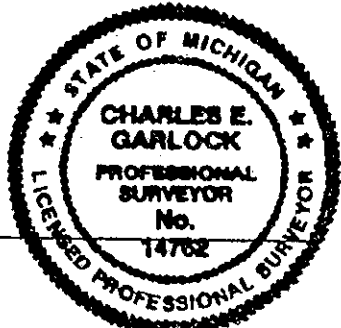

PA 345 1992 APPROVED BY LIVINGSTON COUNTY
FEER GROUP ON 2/26/97 CO. REP JED

"Be Sure of Your Ground"

CHARLES E. GARLOCK

PROFESSIONAL SURVEYOR

705 N. MICHIGAN AVE.

HOWELL, MICHIGAN 48843

OFFICE: (517) 546-3340

FAX: 517 546-2941

FEBRUARY 19, 1997

CORNER SUMMARY

H-13: S 1/4 COR. SEC. 34 T2N-R4E, MARION TWP. LIV. CO. MI.

GLO SURVEY DATED APRIL 15, 1825 BY S SIBLEY AND ONE OF THE TWO GLO WITNESSES REMAIN.

FAIRCHILD IN 1838 WITNESSED THIS CORNER TO AN 8" B OAK-N76 1/2W-76 LKS (50.16') AND BULLOCK IN 1902 WITNESSED THIS CORNER TO A 28" B OAK-N5E-34 LKS (22.44'). WE DID NOT FIND THE CORNER, BUT A MEASURE FROM A 44" R OAK-N75W-50.16' INTERSECTED A MEASURE FROM A 36" R OAK STUB-NORTH-22.44' IN THE CENTERLINE OF THE WB LAND OF SCHAFER ROAD AT A POINT THAT IT ALSO LINES WITH THE REMAINS AN OLD FENCE LINE AND HEDGE ROW TO THE NORTH. WE THEN DISCOVERED FAIRCHILDS WITNESS WAS A GLO WITNESS FROM 1825-IT APPEARS WE FOUND AN ORIGINAL GLO WITNESS TREE. THIS TREE IS FORKED AND LOCATED ABOUT 20' NORTH OF THE CENTERLINE OF SCHAFER ROAD AND ITS HARD TO BELIEVE IT HAS REMAINED ALL THESE YEARS SO NEAR THE CENTERLINE. WE EXAMINED THE TREE FOR MARKINGS AND FOUND NONE. A CHECK IN A FORESTRY BOOK STATES IT IS POSSIBLE THIS TREE COULD LIVE 300 TO 350 YEARS. FOUND NO OTHER WITNESSES TO THE CORNER. THE N 1/4 COR. OF SEC. 3 PUTNAM TWP. WAS FOUND 28.09' TO THE EAST AND 5.29' SOUTH OF A LINE BETWEEN THE PK SPIKE SET AT THE WITNESS INTERSECTION AND THE SE COR. OF SECTION 35. MEASURES WEST ARE 2651.22 = DUNNING '12 AND WE HAD 2651.94 IN '97. THE BALANCE OF MEASURES WEST WERE BASED ON 1/2 MILE DISTANCES BETWEEN THE NW AND N 1/4 COR. OF SECTION 3 PUTNAM AND THE FOUND JOG DISTANCES. WE MEASURED EAST 2642.61 AND MUNSELL HAD 2646.46 BASED ON THE PUTNAM TWP. MEASURES. SITE IS NOT GOOD FOR GPS.

BECAUSE OF THE TWO REMAINING WITNESSES, THE ALIGNMENT TO THE NORTH WITH THE FENCE AND HEDGE ROW AND THE NEARNESS TO DUNNING MEASURE TO THE WEST WE RECOMMEND THE PLACEMENT OF H-13 AT THE INTERSECTION OF THE TWO WITNESSES. THE CALCULATED JOG AT THIS CORNER IS 0.33' WEST.

NOTE: THE PLACEMENT OF THE SE COR. OF SECTION 34 IN THE '93 REMON PROGRAM WAS VERY SIMILAR, WE HAD A VERY OLD WITNESS, AN OLD FENCE LINE NORTH AND AN OLD MEASURE EAST A 1/2 MILE THAT COMPARED

Charles E. Garlock

CHARLES E GARLOCK

PS 14762

MAR97H13

SUCCESSOR TO:

- MILES W. BULLOCK, L.S. (1844 TO 1926) ● GRANT H DUNNING, P.E. (1865 TO 1928)
- CLAY W. GORDON, RLS (1883 TO 1970) ● LYLE W. MUNSELL, RLS (1904 TO 1987)

ZNAE H-13 4