

LAND CORNER RECORDATION CERTIFICATE
Filing Requirement of Act 74, Mich. P.A. 1970

FILED

For corners in

Livingston
(County)

Located In:

Corner Code #

1996 NOV -5 P 2:11

- | | | |
|------------------------------------|-------------------------|------------|
| 1. Public Land Survey | T <u>2N</u> R <u>4E</u> | <u>I-1</u> |
| | T _____ R _____ | _____ |
| | T _____ R _____ | _____ |
| | T _____ R _____ | _____ |
| 2. Property Controlling in Section | S _____ T _____ R _____ | _____ |
| | S _____ T _____ R _____ | _____ |
| 3. Miscellaneous Property in Sec. | S _____ T _____ R _____ | _____ |
| | S _____ T _____ R _____ | _____ |

NANCY HAVILAND
REGISTER OF DEEDS
LIVINGSTON COUNTY, MI.
48843

L.S.C. #566m

Register of Deeds Stamp & File Number

4. Lot No. _____, Recorded Plat _____
5. Private Claims _____

	A	B	C	D	E	F	G	H	I	J	K	L	M
2	6		5		4		3		2		1		
3													
4	7		8		9		10		11		12		
5													
6	18		17		16		15		14		13		
7													
8	19		20		21		22		23		24		
9													
10	30		29		28		27		26		25		
11													
12	31		32		33		34		35		36		
13													


I, Charles E Garlock, in a field survey on October 24, 1996, do hereby certify that under requirements of P.A. 74, Michigan P.A. of 1970, the corner points mentioned in lines 1 and 2 above were in conformance with regulations and rules therefore as required in the current manual of survey instructions of the United States Department of the Interior, Bureau of Land Management or by a decree of a Court of Law and/or that the corner points mentioned in lines 3, 4 and 5 above were in conformance with the rules of the Michigan Board of Land Surveyors or by a Decree of a Court of Law; established, re-established, monumented, re-monumented, recovered, found as expressed below:

NOTE: Not more than 4 corners, all in the same town and range, may be recorded on this certificate.

- A. Description of original monument and accessories and/or subsequent restoration:
GLO survey dated: April 25, 1825 by S Sibley DS
GLO witnessess: B016-S29W-42 Iks
 W0 08-S48E-20 Iks

Additional historical data on rear of sheet

- B. Description of corner evidence found and/or method applied in restoring or reestablishing corner:
Fd. 1" X 30" I. Pipe with State of Michigan brass cap 4" dia. on top, set in 1926 by State of Michigan for State San property. Iron and cap located in a Mon. Box and is 0.15 feet south of the East-West Township line and on the section line between Sections 2 & 3.

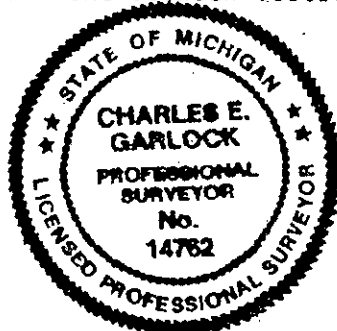

P.A. 345 1990, APPROVED BY LIVINGSTON COUNTY
PEER GROUP ON 2-7-96 CO. REP JED

- C. Description of monument for corner and accessories established to perpetuate locating the position of the corner:
I-1: Northwest corner Section 2 T2N-R4E, Marion Twp. Liv. Co. MI. Left I. Pipe and cap as found, which is located 0.15 feet South of the Twp. line and witnessed/as follows:
N55W-61.80'-sp and Tag E/s 40" W Oak
S15W-32.69'- Sp & tag W/s 15" Box Elder
N79E-62.47'-sp & tag S/s U Pole
N66E-72.20'-sp & tag S/s 12" Elm
North 3.0'± centerline Mason Road
West-201.89 feet- SW corner Section 35 T3N-R4E

Signed by Charles E Garlock Date October 26, 1996
Surveyor's Michigan License No. 14762

CORNER SUMMARY

1-1: NORTHWEST CORNER, SECTION 2, T2N-R4E, MARION TOWNSHIP,
LIVINGSTON COUNTY, MICHIGAN.

GLO SURVEY DATED APRIL 15, 1825 BY S SIBLEY, DS, AND NONE OF THE
GLO WITNESSES REMAIN.

NEXT KNOWN ACTIVITY WAS 1910 WHEN G DUNNING WITNESSED THE CORNER.
IN 1926 WHEN THE STATE OF MICHIGAN SURVEYED THE STATE SAN PROPERTY
THEY SET A 1" X 30" I. PIPE WITH A BRASS CAP AT THE CORNER G
DUNNING HAD USED IN 1910. SINCE 1926 ALL KNOWN SURVEYORS HAVE
CONTINUED TO USE THIS CORNER WITH MANY OF THE WITNESSES FROM 1910
AND 1926 REMAINING, SURVEYORS ARE: C GORDON-1939 & 1959, MDOT (A
PIERSON)-1965, BOSS-1972 & 1978, BENTON-1976 AND MYSELF-1989 &
1993. MEASURES EAST TO THE NORTH 1/4 CORNER ARE: 2695.33 BY
MDOT, 2601.76 BY BENTON AND 2602.72 BY MYSELF. MEASURES SOUTH TO
THE W 1/4 CORNER ARE: 3911.16 BY C GORDON, 3916.53 BY BOSS,
BENTON AND MYSELF AND 3919.60 BY F SOLL (1926). WE FOUND A 1/2"
I. ROD IN A MON BOX THAT WAS RAISED ABOVE THE 1" I. PIPE WITH
BRASS CAP, ABOUT 2.5 FT. SOUTH OF THE CENTERLINE OF MASON RD.
(ASPHALT CONSTR.) WITH AN OLD FENCE LINE TO THE SOUTH. CORNER IS
LOCATED 201.89 FT. EAST OF THE SOUTHWEST CORNER OF SECTION 35,
HOWELL TOWNSHIP AND 0.15 FT. SOUTH OF THE TOWNSHIP LINE. TOO MANY
TREES AROUND THE CORNER FOR A GOOD GPS SITE.
RECOMMEND WE REMOVE THE 1/2" I. ROD AND BRASS CAP BY THE STATE AND
REPLACE IT WITH A 6" BREAKAWAY I. PIPE WITH A LIVINGSTON COUNTY
REMON CAP (IF POSSIBLE). IF THIS CAN NOT BE DONE, THEN LEAVE THE
STATE OF MICHIGAN CAP UNCOVERED. THE PRESENT POSITION OF THIS
CORNER MAY WELL BE ON THE TOWNSHIP LINE AND I WOULD LEAVE IT AS
FOUND.



CHARLES E GARLOCK
PS 14762
MAR9611

2N4E I 1

4