

SURVEY & REMONUMENTATION

FEB 25 1999

LAND CORNER RECORDATION CERTIFICATE
Filing Requirement of Act 74, Mich. P.A. 1970

FILED

For corners in **SECTION**

LIVINGSTON
(County)

Located In:

Corner Code #

- | | | | |
|------------------------------------|--------------|--------------|-----------|
| 1. Public Land Survey | T <u>2</u> N | R <u>4</u> E | <u>17</u> |
| | T | R | |
| | T | R | |
| | T | R | |
| 2. Property Controlling in Section | S | T | R |
| | S | T | R |
| 3. Miscellaneous Property in Sec. | S | T | R |
| | S | T | R |

91
1998 AUG 20 P 4: 46
NANCY HAVILAND
REGISTER OF DEEDS
LIVINGSTON COUNTY, MI.
48843
L.S.C. #888m
Register of Deeds Stamp & File Number


4. Lot No. _____, Recorded Plat _____
5. Private Claims _____

I, CHARLES E GARLOCK, in a field survey on AUG 13, 19 98 do hereby state that under requirements of P.A. 74, Michigan P.A. of 1970, the corner points mentioned in lines 1 and 2 above were in conformance with regulations and rules therefore as required in the current manual of survey instructions of the United States Department of the Interior, Bureau of Land Management or by a decree of a Court of Law and /or that the corner points mentioned in lines 3, 4 and 5 above were in conformance with the rules of the Michigan Board of Land Surveyors or by a Decree of a Court of Law; established, re-established, monumented, recovered, found as expressed below:

NOTE: Not more than 2 corners, all in the same town and range, may be recorded on this certificate.

	A	B	C	D	E	F	G	H	I	J	K	L	M
1													
2	6		5		4		3		2		1		
3													
4	7		8		9		10		11		12		
5													
6	10		17		16		15		14		13		
7													
8	19		20		21		22		23		24		
9													
10	30		29		28		27		26		25		
11													
12	31		32		33		34		35		36		
13													

A. Description of original monument and accessories and/or subsequent restoration:
GLO SURVEY DATED APRIL 15, 1825 BY S SIBLEY
GLO WITNESSES: ELM 9-N88E-33 LKS
BO 24-S88W-30 LKS

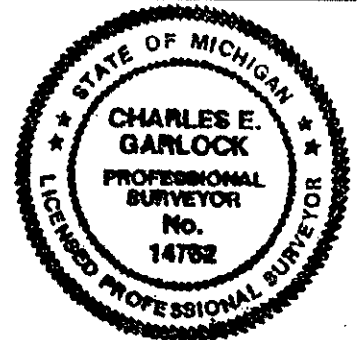

B. Description of corner evidence found and/or method applied in restoring or reestablishing corner:
FOUND 1/2" I. ROD WITH J ALBRIGHT CAP (DETROIT EDISON SURVEY)

C. Description of monument for corner and accessories established to perpetuate locating the position of the corner:
I7: SE COR. SEC. 15 T2N-R4E, MARION TWP. LIV. CO. MI., REPLACED 1/2" I. ROD WITH 1 1/4" X 36" PIPE WITH LIV. CO. REMON. BRASS CAP ON TOP. SET CARSONITE POST BESIDE SET I. PIPE.
NORTH-40.00'-1" X 36" REMON WITNESS I. PIPE W/WITNESS CAP IN TOP
S10W-59.25'-SP 7 TAG W/S 12" OAK
S30W-75.51'-SP & TAG W/S 14' HICKORY
S50W-76.05'-SP & TAG W/S 10" BIRCH

Signed by [Signature]
Surveyor's Michigan License No. 14762

Date AUGUST 13, 1998

PA. 345 1990, APPROVED BY LIVINGSTON COUNTY
PEER GROUP ON 6/3/98 CO. REP JED