

**SURVEY & REMONUMENTATION**

FEB 25 1999

**SECTION**

**LAND CORNER RECORDATION CERTIFICATE**  
Filing Requirement of Act 74, Mich. P.A. 1970

**FILED**

For corners in

<u>LIVINGSTON</u> (County)	Located In:	Corner Code #
1. Public Land Survey	T <u>2N</u> R <u>4E</u>	<u>J7</u>
	T ___ R ___	_____
	T ___ R ___	_____
	T ___ R ___	_____
2. Property Controlling in Section	S ___ T ___ R ___	_____
	S ___ T ___ R ___	_____
3. Miscellaneous Property in Sec.	S ___ T ___ R ___	_____
	S ___ T ___ R ___	_____
4. Lot No. _____, Recorded Plat _____		
5. Private Claims _____		

91  
1998 AUG 20 P 4:46  
NANCY HAVILAND  
REGISTER OF DEEDS  
LIVINGSTON COUNTY, MI.  
48843  
L.S.C. #887m  
Register of Deeds Stamp & File Number


I, CHARLES E GARLOCK, in a field survey on AUG 13, 1998 do hereby state that under requirements of P.A. 74, Michigan P.A. of 1970, the corner points mentioned in lines 1 and 2 above were in conformance with regulations and rules therefore as required in the current manual of survey instructions of the United States Department of the Interior, Bureau of Land Management or by a decree of a Court of Law and /or that the corner points mentioned in lines 3, 4 and 5 above were in conformance with the rules of the Michigan Board of Land Surveyors or by a Decree of a Court of Law; established, re-established, monumented, recovered, found as expressed below:

NOTE: Not more than 2 corners, all in the same town and range, may be recorded on this certificate.

A	B	C	D	E	F	G	H	I	J	K	L	M
1												
2	6		5		4		3		2		1	
3												
4	7		8		9		10		11		12	
5												
6	18		17		16		15		14		13	
7												
8	19		20		21		22		23		24	
9												
10	30		29		28		27		26		25	
11												
12	31		32		33		34		35		36	
13												

A. Description of original monument and accessories and/or subsequent restoration:

GLO SURVEY DATED APRIL 15, 1825, BY S SIBLEY  
GLO WITNESSES: B ASH S11E-14 LKS  
B ASH N52E-13 LKS

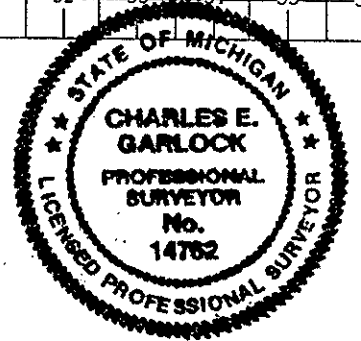

B. Description of corner evidence found and/or method applied in restoring or reestablishing corner:

FD. 4" STEEL POST WITH 1/2" I. ROD AND CAP CEMENTED IN THE TOP WHICH LINES WITH OLD FENCE LINES TO THE NORTH AND EAST.

C. Description of monument for corner and accessories established to perpetuate locating the position of the corner:

J7: S 1/4 COR. SEC. 14 T2N-R4E, MARION TWP. LIV. CO MI, REPLACED 1/2" I ROD AND CAP WITH A LIV. CO. REMON. BRASS CAP IN TOP OF THE 4" STEEL POST 4" STEEL POST IS +3.00 FEET ABOVE GROUND.  
S26W-88.04'-SP & TAG E/S 16" CHERRY  
S58E-61.85'-SP & TAG W/S 10" MAPLE  
N21E-79.84'-2 1/4" BOLT IN HIGH LINE TOWER WITH "X" IN TOP.  
S82W-94.14'-SP & TAG N/S 16" ASH

Signed by Charles E. Garlock  
Surveyor's Michigan License No. 14762

Date AUGUST 13, 1998