

LAND CORNER RECORDATION CERTIFICATE
Filing Requirement of Act 74, Mich. P.A. 1970

For corners in
Livingston
 (County)

Located In: _____ Corner Code ##

- | | | |
|------------------------------------|-------------------------|------------|
| 1. Public Land Survey | T <u>2N</u> R <u>4E</u> | <u>K-2</u> |
| | T _____ R _____ | _____ |
| | T _____ R _____ | _____ |
| | T _____ R _____ | _____ |
| 2. Property Controlling in Section | S _____ T _____ R _____ | _____ |
| | S _____ T _____ R _____ | _____ |
| 3. Miscellaneous Property in Sec. | S _____ T _____ R _____ | _____ |
| | S _____ T _____ R _____ | _____ |
4. Lot No. _____, Recorded Plat _____
5. Private Claims _____

9
 NANCY HAVILLAND
 REGISTER OF DEEDS
 LIVINGSTON COUNTY, MI
 48843
 MAR 30 3 46 PM '96
 FILED

L.S.C.#539m
 Register of Deeds Stamp & File Number

	A	B	C	D	E	F	G	H	I	J	K	L	M
2	6	5	4	3	2	1							
3													
4	7	8	9	10	11	12							
5													
6	18	17	16	15	14	13							
7													
8	19	20	21	22	23	24							
9													
10	30	29	28	27	26	25							
11													
12	31	32	33	34	35	36							
13													

I, Charles E Garlock, in a field survey on May 23, 19 96, do hereby certify that under requirements of P.A. 74, Michigan P.A. of 1970, the corner points mentioned in lines 1 and 2 above were in conformance with regulations and rules therefore as required in the current manual of survey instructions of the United States Department of the Interior, Bureau of Land Management or by a decree of a Court of Law and/or that the corner points mentioned in lines 3, 4 and 5 above were in conformance with the rules of the Michigan Board of Land Surveyors or by a Decree of a Court of Law; established, re-established, monumented, re-monumented, recovered, found as expressed below:

NOTE: Not more than 4 corners, all in the same town and range, may be recorded on this certificate.

- A. Description of original monument and accessories and/or subsequent restoration:
 GLO survey dated April 15, 1825 by S Sibley, DS
 GLO witnesses: BO 9-S40½E-53 lks
 BO 10-S29½W-198 lks


**SURVEY &
 REMONUMENTATION**

AUG 06 1996

COMMISSION

Additional historical data on rear of sheet.

- B. Description of corner evidence found and/or method applied in restoring or reestablishing corner:
 Found 1/2" X 18" I. Pipe in Mon. Box about 1'± North of channel iron post marker

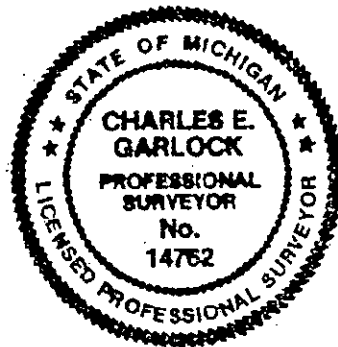

- C. Description of monument for corner and accessories established to perpetuate locating the position of the corner:
 K-2: W 1/4 cor. Sec. 1, T2N-R4E, Marion Twp. Liv.Co.MI. reset I. Pipe found with 1 1/4" X 36" I. Pipe with Liv. Co. Remon brass cap on top at -0.2' in found Mon. Box.
 N85W-33.68'-sp & tag N/s 7" Locust
 North-32.23'-sp & tag top of guard post at East end of guard railing.
 N40E-24.44'-S. edge of Concrete shoulder EB I-96 at its nearest point to corner.
 S5E-74.37'-sp & tag W/s 6" Cedar
 S10E-88.25'-sp & tag E/s triple 18" Poplar
 South-1'± fence post channel iron.

P.A. 345 1880, APPROVED BY LIVINGSTON COUNTY
 PEER GROUP ON 2-21-96, CO. REP. JED

Signed by Charles E. Garlock Date May 23, 1996
 Surveyor's Michigan License No. 14762


CORNER SUMMARY

~~CONFIDENTIAL~~
PROPERTY OF THE MICHIGAN DEPARTMENT OF LAND AND NATURAL RESOURCES

K-2: WEST 1/4 CORNER, SECTION 1, T2N-R4E, MARION TOWNSHIP,
LIVINGSTON COUNTY, MICHIGAN.

GLO SURVEY DATED APRIL 15, 1825 BY S SIBLEY AND NONE OF THE GLO
WITNESSES REMAIN.

FOUND NO EARLY ACTIVITY BY SURVEYORS PRIOR TO 1948, WHEN C GORDON
WITNESSED SAID CORNER IN LINE WITH FENCES EAST AND WEST AS DID L
MUNSELL IN 1959. SINCE THAT TIME THE FOLLOWING KNOWN SURVEYORS
HAVE USED THIS SAME CORNER: MDOT, MUNSELL, BENTON, BOSS, THOMPSON
WARD AND MYSELF. THE ONLY WITNESSES THAT REMAIN ARE WHOSE BY G
WARD AND THEY CHECK, ALL THE OLDER WITNESSES HAVE BEEN DESTROYED
BY THE CONSTRUCTION AND RE-CONSTRUCTION OF I-96 IN THE 1960'S AND
1990'S. CORNER WAS FOUND TO BE A 1/2" I. PIPE IN A MON. BOX. TWO
ACT 74'S HAVE BEEN RECORDED AND EIGHT ACT 132'S. MEASURES NORTH
ARE: 3863.03 BY MDOT & BENTON, 3862.78 BY MYSELF, 3862.44 BY
MYSELF & BENTON, 3862.27 BY BOSS, 3862.36 BY BOSS, 3862.88 BY
BENTON, AND 3862.27 BY THOMPSON. MEASURES SOUTH ARE: 2617.23 BY
BENTON, 2617.86 BY BENTON & MDOT, AND 2617.38 BY BOSS. MEASURES
EAST ARE: 5201.80 BY BOSS AND 5201.70 BY BENTON. MEASURE WEST OF
2562.95 BY BOSS. ALL MEASURES APPEAR TO BE CONSISTENT AND TO THE
SAME CORNER. SOME TREES SURROUND THE AREA AND A GPS SITE IS
QUESTIONABLE. CORNER IS ON OLD ABANDONED PORTION OF PINCKNEY ROAD
ON I-96 RIGHT-OF-WAY. I WOULD RECOMMEND CONTINUED USE OF THIS
CORNER.

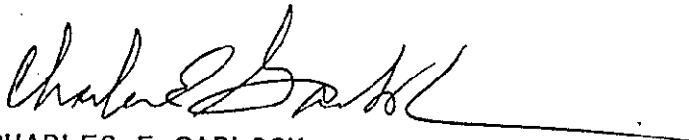

CHARLES E GARLOCK
PS14762
MAR96K2

ZNAE K2
7/11/11

4