

LAND CORNER RECORDATION CERTIFICATE
 Filing Requirement of Act 74, Mich. P.A. 1970

SARCI HAVILAN
 REGISTER OF DEEDS
 LIVINGSTON COUNTY
 48243

JUN 5 10 37 AM '95

FILED

For corners in
Livingston
 (County)

Located In:	Corner Code #
T2N R 4E	K-3
T _____ R _____	_____
T _____ R _____	_____
T _____ R _____	_____
T _____ R _____	_____
S _____ T _____ R _____	_____
S _____ T _____ R _____	_____
S _____ T _____ R _____	_____
S _____ T _____ R _____	_____

C.L.S. #400 m

Register of Deeds Stamp & File Number

1. Lot No. _____, Recorded Plat _____
 2. Private Claims _____

	A	B	C	D	E	F	G	H	I	J	K	L	M
2	6	5	4	3	2	1							
3													
4	7	8	9	10	11	12							
5													
6	10	17	16	15	14	13							
7													
8	19	20	21	22	23	24							
9													
10	30	29	28	27	26	25							
11													
12	31	32	33	34	35	36							
13													

Charles E Garlock, in a field survey on May 30, 19 95,
 hereby certify that under requirements of P.A. 74, Michigan P.A. of 1970, the corner points mentioned
 in lines 1 and 2 above were in conformance with regulations and rules therefore as required in the
 current manual of survey instructions of the United States Department of the Interior, Bureau of Land
 Management or by a decree of a Court of Law and/or that the corner points mentioned in lines 3, 4 and 5
 above were in conformance with the rules of the Michigan Board of Land Surveyors or by a Decree of a
 Court of Law; established, re-established, monumented, re-monumented, recovered, found as
 expressed below:

NOTE: Not more than 4 corners, all in the same town and range, may be recorded
 on this certificate.

Description of original monument and accessories and/or subsequent restoration:
 GLO survey dated: April 15, 1825 by S Sibley, DS
 GLO witnesses: B Ash 8-S89W-37 lks
 B Ash 10-S69E-11 lks


Additional historical survey data on rear of sheet
 Description of corner evidence found and/or method applied in restoring or reestablishing corner:
 Found 1/2" I. Rod in Man Box

**SURVEY &
 REMONUMENTATION**

 OCT 0 2 1995

 COMMISSION

Description of monument for corner and accessories established to perpetuate locating the position of the corner:
 K-3: NW corner Section 12, T2N-R4E, Marion Twp. Liv. Co. MI, reset found 1/2" I. Rod with
 1 1/4" X 36" breakaway I. Pipe with Liv. Co. Remon. brass cap on top at -0.5'
 S25W-102.29'-sp & tag E/s 20" Poplar
 S20E-173.16'-sp & tag W/s 9" Poplar
 S30E-95.27'-sp & tag W/s 12" Poplar
 S45E-64.00'-sp & tag N/s U. Pole
 East-0.75'-c/l Pinckney Road
 South-11.27'-c/l Francis Road to the East

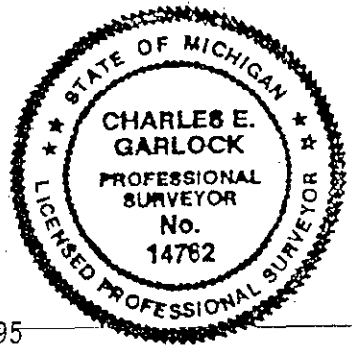

Surveyed by: Charles E Garlock Date: May 30, 1995
 Surveyor's Michigan License No. 14762


CORNER SUMMARY

K-3: NW COR. SEC. 12, T2NR4E, MARION TWP., LIV. CO., MI

GLO SURVEY DATED APRIL 15, 1825 BY S SIBLEY AND NONE OF THE GLO WITNESSES REMAIN.

NEXT KNOWN ACTIVITY WAS BY L MUNSELL IN 1961 WHEN HE SET A 1/2" I. ROD ON THE CENTERLINE OF PINCKNEY ROAD AND IN LINE WITH A FENCE TO THE WEST DURING A FEDERAL AID ROAD SURVEY. SINCE THEN BENTON, BOSS, BRADY, NEWTON AND MYSELF HAVE USED SAID IRON, NOW LOCATED IN A MON. BOX. MANY OF PAST WITNESSES WERE TO THE SAME OBJECTS UP UNTIL 1991, BUT SINCE THAT TIME ALL WITNESSES POINTS HAVE BEEN DESTROYED EXCEPT ONE DATING FROM 1969 AND HAD BEEN USED BY ALL OF THE ABOVE EXCEPT MUNSELL; THIS WITNESS STILL CHECKS PRESENTLY. MEASURES SOUTH TO THE 1/4 COR. ARE: 2628.75 BY BRADY AND 2628.69 & 2629.24 BY MYSELF. EAST TO THE N 1/4 COR. ARE: 2593.43 BY BRADY, 2593.43 BY BOSS AND 2593.20 BY BENTON. FOUND NO ACT 74'S RECORDED, BUT FOUND 25 ACT 132'S TIED TO THIS CORNER. GOOD SITE FOR GPS STATION.

Charles E. Garlock
CHARLES E GARLOCK
PS 14762

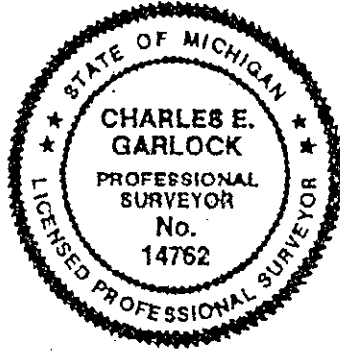

K3MAR95

T2NR4E
K-3
4