

LAND CORNER RECORDATION CERTIFICATE
 Filing Requirement of Act 74, Mich. P.A. 1970

91

For corners in

Livingston
(County)

Located In:

Corner Code ##

- | | | |
|------------------------------------|-------------------------|------------|
| 1. Public Land Survey | T <u>2N</u> R <u>4E</u> | <u>K-4</u> |
| | T _____ R _____ | _____ |
| | T _____ R _____ | _____ |
| | T _____ R _____ | _____ |
| 2. Property Controlling in Section | S _____ T _____ R _____ | _____ |
| | S _____ T _____ R _____ | _____ |
| 3. Miscellaneous Property in Sec. | S _____ T _____ R _____ | _____ |
| | S _____ T _____ R _____ | _____ |

NANCY HAYLAND
 REGISTER OF DEEDS
 LIVINGSTON COUNTY, MICH.
 43843
 JUN 5 10 38 AM '95
 FILED
 C. L. S. #402m
 Register of Deeds Stamp & File Number

4. Lot No. _____, Recorded Plat _____
5. Private Claims _____

Charles E Garlock in a field survey on May 30 19 95

I hereby certify that under requirements of P.A. 74, Michigan P.A. of 1970, the corner points mentioned in lines 1 and 2 above were in conformance with regulations and rules therefore as required in the current manual of survey instructions of the United States Department of the Interior, Bureau of Land Management or by a decree of a Court of Law and/or that the corner points mentioned in lines 3, 4 and 5 above were in conformance with the rules of the Michigan Board of Land Surveyors or by a Decree of a Court of Law; established, re-established, monumented, re-monumented, recovered, found as expressed below:

NOTE: Not more than 4 corners, all in the same town and range, may be recorded on this certificate.


Description of original monument and accessories and/or subsequent restoration:
 GLO survey dated: April 15, 1825 by S Sibley DS.
 GLO witnesses: WO 9-N84½E-46 lks
 WO 25-S72W-46 lks

	A	B	C	D	E	F	G	H	I	J	K	L	M
2	6	5	4	3	2								
3													
4	7	8	9	10	11	12							
5													
6	18	17	16	15	14	13							
7													
8	19	20	21	22	23	24							
9													
10	30	29	28	27	26	25							
11													
12	31	32	33	34	35	36							
13													

Additional historical survey data on rear of sheet
 Description of corner evidence found and/or method applied in restoring or reestablishing corner:
 Found 1/2" I. Rod in Mon. Box, occupation lines to the East and West and on c/l of Pinckney Road North & South

SURVEY &
 REMONUMENTATION
 OCT 0 8 1995
 COMMISSION

Description of monument for corner and accessories established to perpetuate locating the position of the corner:
 K-4: West 1/4 corner of Section 12, T2N-R4E. Marion Twp. Liv. Co. MI., reset found 1/2" I. Rod with 1 1/4" X 36" breakaway I. Pipe with Liv. Co. Remon brass cap on top at -0.5' N30W-95.03'-sp & tag E/s 6" Box Elder
 N65E-137.36'-NW corner of Conc. porch wood post.
 N88E-56.68'-sp & tag S/s 6" Pine
 S45W-171.51'-NE corner of House
 On c/l of Pinckney Road North & South
 on line with fence to West and occupation to the East.

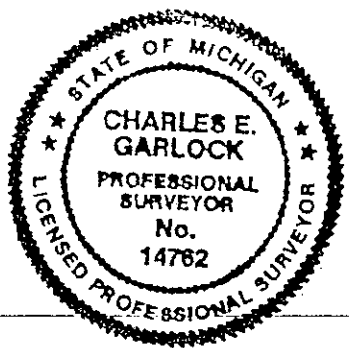

Recorded by Charles E. Garlock Date May 30, 1995
 Surveyor's Michigan License No. 14762

CORNER SUMMARY


K-4: W 1/4 COR. SEC. 12, T2N-R4E, MARION TWP., LIV. CO., MI

GLO SURVEY DATED APRIL 15, 1825 BY S SIBLEY AND NONE OF THE GLO WITNESSES REMAIN.

IN 1899 M BULLOCK SAID CORNER WAS A PLOW POINT AND A STONE 23" x 9" x 9" (PROBABLY REMOVED DURING RECONSTRUCTION OF PINCKNEY ROAD IN THE 1960'S). NEXT KNOWN ACTIVITY WAS IN 1957 WHEN L MUNSELL SET A 1/2" I. ROD ON THE CENTERLINE OF PINCKNEY ROAD AND IN LINE WITH FENCES TO THE EAST AND WEST, A MON. BOX WAS SET AROUND THIS POINT DURING THE RECONSTRUCTION OF PINCKNEY ROAD. SURVEYORS THAT HAVE SINCE USED THIS IRON ARE: BENTON, BOSS, BRADY AND MYSELF. THE ONLY WITNESSES THAT REMAIN ARE BY THIS OFFICE AND THEY CHECK. MEASURES NORTH TO THE SEC. COR. ARE: 2628.75 BY BRADY, 2628.69 BY MYSELF AND 2629.24 BY MYSELF. MEASURES SOUTH TO THE SEC. CORNER ARE: 2630.22 & 2630.24 BY BOSS AND 2628.50 BY MYSELF FROM A COMBINATION OF SEVERAL SURVEYS IN THE 1960'S. MEASURES EAST TO THE CENTER OF SEC. ARE: 2552.50 BY BOSS, 2552.77 BY BRADY AND 2550.67 BY MYSELF TO A FOUND IRON THAT WAS STUCK HALF WAY IN THE GROUND AND TILTED, ASSUMED IT HAD BEEN PULLED. NO ACT 74'S RECORDED AND THREE ACT 132'S HAVE BEEN RECORDED TO THIS CORNER. THIS IS A GOOD GPS STATION, EXCEPT FOR TRAFFIC.

CHARLES E GARLOCK
PS 14762

K4MAR95

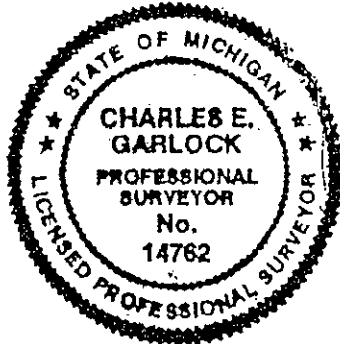

RV4E 1244