

LAND CORNER RECORDATION CERTIFICATE
Filing Requirement of Act 74, Mich. P.A. 1970

9-

HAROLD HAVILLAND
 REGISTER OF DEEDS
 LIVINGSTON COUNTY, MI
 48843

JUN 5 10 38 AM '95

FILED

For corners in Livingston (County) Located In: Corner Code ##

1. Public Land Survey	T <u>2</u> N	R <u>4</u> E	<u>K-5</u>
	T _____	R _____	_____
	T _____	R _____	_____
	T _____	R _____	_____
2. Property Controlling in Section	S _____	T _____	R _____
	S _____	T _____	R _____
3. Miscellaneous Property in Sec.	S _____	T _____	R _____
	S _____	T _____	R _____

4. Lot No. _____, Recorded Plat _____

5. Private Claims _____

C. L. S. #403m
 Register of Deeds Stamp & File Number

	A	B	C	D	E	F	G	H	I	J	K	L	M
2	6	5	4	3	2	1							
3													
4	7	8	9	10	11	12							
5													
6	18	17	16	15	14	13							
7													
8	19	20	21	22	23	24							
9													
10	30	29	28	27	26	25							
11													
12	31	32	33	34	35	36							
13													

Charles E Garlock in a field survey on May 30, 19 95
 I hereby certify that under requirements of P.A. 74, Michigan P.A. of 1970, the corner points mentioned in lines 1 and 2 above were in conformance with regulations and rules therefore as required in the current manual of survey instructions of the United States Department of the Interior, Bureau of Land Management or by a decree of a Court of Law and/or that the corner points mentioned in lines 3, 4 and 5 above were in conformance with the rules of the Michigan Board of Land Surveyors or by a Decree of a Court of Law, established, re-established, monumented, re-monumented, recovered, found as expressed below:


NOTE: Not more than 4 corners, all in the same town and range, may be recorded on this certificate.

- Description of original monument and accessories and/or subsequent restoration:
 GLO survey dated: April 15, 1825 by S Sibley DS.
 GLO witnesses: W0 20-N2W-99 lks
 W0 7-S22½E-110 lks

Additional historical survey data on rear of sheet.
 Description of corner evidence found and/or method applied in restoring or reestablishing corner:
 Found 1/2" I. Rod in Mon. Box

SURVEY &
 REMONUMENTATION
 OCT 6 8 1995
 COMMISSION

Description of monument for corner and accessories established to perpetuate locating the position of the corner:
 K-555 SW corner Section 12, T2N-R4E, Marion Twp., Liv. Co., MI reset found 1/2" I. Rod with 1 1/4" X 36" breakaway I. Pipe with Liv. Co. Remon brass cap on top at -0.5'
 N70W-44.37'-sp & tag N/s 6" Oak
 N30E-114.29'-sp & tag W/s 40" oak
 N40E-64.35'-sp & tag W/s 24" Maple
 S45E-45.82'-sp & tag S/s 38" Oak
 North-7.65'-c/l Wright Road to the East
 West-1.0'-c/l Pinckney Road North & South
 Fence line to the West.

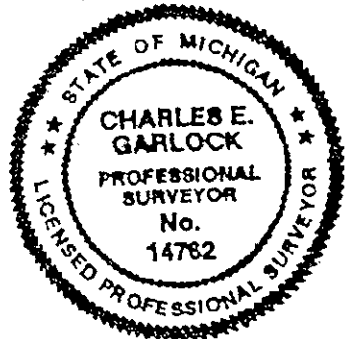

Drawn by Charles E Garlock Date May 30, 1995
 Surveyor's Michigan License No. 14762

CORNER SUMMARY

K-5: SW⁴COR. SEC. 12, T2N-R4E, MARION TWP., LIV. CO., MI


GLO SURVEY DATED APRIL 15, 1825 BY S SIBLEY AND NONE OF THE GLO WITNESSES REMAIN.

M BULLOCK WITNESSED THE CORNER IN 1873 AND 1893 BUT NONE OF THE WITNESSES REMAIN. NEXT KNOWN ACTIVITY WAS BY L MUNSELL IN 1961 WHEN HE SET THE PRESENT 1/2" I. ROD. SINCE THAT TIME BENTON, BOSS, DESINE AND MYSELF HAVE USED THE SAME IRON AND WITNESSES THAT REMAIN CHECK WITH THE 1/2" I. ROD THAT IS IN A MON. BOX ABOUT 1 FT. EAST OF THE CENTERLINE OF PINCKNEY RD. (ASPH CONSTR). SAID IRON IS ON THE CENTERLINE OF WRIGHT RD. TO THE EAST AND IN LINE WITH A FENCE LINE TO THE WEST. MEASURES EAST TO THE 1/4 CORNER ARE: 2518.90 BY NEWMAN, 2518.30 BY MUNSELL, 2518.43 BY DESINE, 2518.90 BY HUGHES, 2518.56 BY BOSS AND 2518.63 BY MYSELF (AVE. OF 2518.62). SOUTH TO THE 1/4 CORNER: 2640.02 BY BOSS, 2639.83 BY DESINE AND 2640.08 BY MYSELF. NORTH TO A 1/4 COR.: 2630.22 BY BOSS AND 2628.5± BY MYSELF. FOUND ONE ACT 74 RECORDED AND FIVE ACT 132'S RECORDED TO THIS CORNER. POINT IS NOT A GOOD GPS STATION DUE TO OVER HANGING TREES.



CHARLES E GARLOCK
PS 14762

K5MAR95

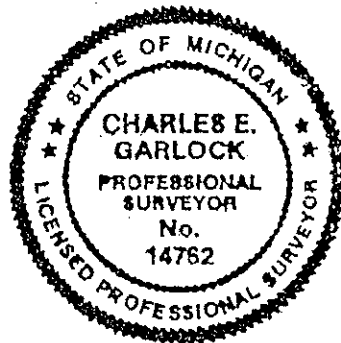

2N-4E-K-5

4