

LAND CORNER RECORDATION CERTIFICATE
 Filing Requirement of Act 74, Mich. P.A. 1970

MARCO HAVILLAN
 REGISTER OF DEEDS
 LIVINGSTON COUNTY, MI
 48843

9-
 JUN 5 10 38 AM '95

FILED

For corners in Livingston (County) Located In: Corner Code 44

1. Public Land Survey	T <u>2N</u> R <u>4E</u>	<u>K-6</u>
	T _____ R _____	_____
	T _____ R _____	_____
	T _____ R _____	_____
2. Property Controlling in Section	S _____ T _____ R _____	_____
	S _____ T _____ R _____	_____
3. Miscellaneous Property in Sec.	S _____ T _____ R _____	_____
	S _____ T _____ R _____	_____

C.L.S. #401m
 Register of Deeds Stamp & File Number

4. Lot No. _____, Recorded Plat _____
 5. Private Claims _____

Charles E. Garlock in a field survey on May 30, 1995,
 I hereby certify that under requirements of P.A. 74, Michigan P.A. of 1970, the corner points mentioned in lines 1 and 2 above were in conformance with regulations and rules therefore as required in the current manual of survey instructions of the United States Department of the Interior, Bureau of Land Management or by a decree of a Court of Law and/or that the corner points mentioned in lines 3, 4 and 5 above were in conformance with the rules of the Michigan Board of Land Surveyors or by a Decree of a Court of Law; established, re-established, monumented, re-monumented, recovered, found as expressed below:

	A	B	C	D	E	F	G	H	I	J	K	L	M
2	6	5	4	3	2	1							
3													
4	7	8	9	10	11	12							
5													
6	18	17	16	15	14	13							
7													
8	19	20	21	22	23	24							
9													
10	30	29	28	27	26	25							
11													
12	31	32	33	34	35	36							
13													


NOTE: Not more than 4 corners, all in the same town and range, may be recorded on this certificate.

Description of original monument and accessories and/or subsequent restoration:
 GLO survey dated: April 15, 1825 by S Sibley DS
 GLO witnesses: BOak 12-N78½E-70 Iks
 W Oak 14-N28W-19 Iks

Additional historical survey data on rear of sheet.
 Description of corner evidence found and/or method applied in restoring or reestablishing corner:
 Found 1/2" I. Rod in Mon. Box on c/l of Sexton Road to the West

SURVEY &
 RE-MONUMENTATION
 OCT 6 1995
 COMMISSION

Description of monument for corner and accessories established to perpetuate locating the position of the corner:
 K-6: West 1/4 corner Section 13, T2N-R4E, Marion Twp. Liv. Co. MI, reset found 1/2" I. Rod with 1 1/4" X 36" breakaway I. Pipe with Liv. Co. Remon brass cap on top at -0.5'
 N70W-87.77'-sp & tag S/s 40" W Oak
 S80W-161.62'-sp & tag N/s U. Pole
 S40E-61.49'-sp & tag W/s U. Pole
 N85E-52.07'-sp & tag S/s 6" Elm
 East-2.0'-c/l Pinkney Road
 On c/l of Sexton Road to the West

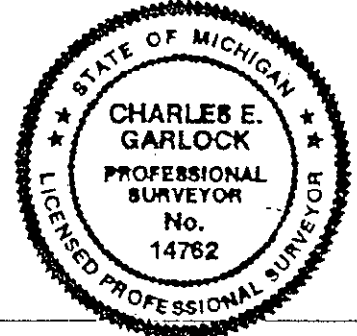

Surveyed by Charles E. Garlock Date May 30, 1995

Surveyor's Michigan License No. 14762

CORNER SUMMARY

K-6: W 1/4 COR. SEC. 13, T2N-R4E, MARION TWP., LIV. CO., MI


GLO SURVEY DATED APRIL 15, 1825 BY S SIBLEY AND NONE OF THE WITNESSES REMAIN.

M BULLOCK WITNESSED THIS CORNER IN 1873, WITNESS GONE NOW. NEXT KNOWN ACTIVITY WAS IN 1961 WHEN I SET A 1/2" I ROD ON THE EXISTING CENTERLINE OF PINCKNEY ROAD, ON A FENCE LINE TO THE EAST AND NEAR THE CENTERLINE OF SEXTON ROAD TO THE WEST; THIS WAS DURING A FEDERAL AID PROJECT FOR THE RECONSTRUCTION OF PINCKNEY ROAD. TWO WITNESS POINTS ESTABLISHED THEN ARE STILL PRESENT TODAY AND HAVE BEEN USED BY ALBRIGHT, BENTON, BOSS, DESINE, HUGHES AND MYSELF TOGETHER WITH ADDITIONAL WITNESSES, ALL THAT REMAIN CHECK PRESENTLY. EXCEPT IN 1970 A TIE TO A RR TIE FENCE POST WAS LISTED AT 32.54 FT., IT MEASURES ABOUT 1.5 FT FURTHER, BUT THREE OF US SINCE, HAVE SWORN TO THE ORIGINAL MEASURE, A FAULT OF SURVEYORS. MEASURE NORTH TO THE SECTION CORNER ARE: 2639.83 BY DESINE, 2640.02 BY BOSS AND 2640.08 BY MYSELF. EAST TO THE CENTER OF SECTION: 2518.22 BY DESINE, 2518.90 BY HUGHES AND 2519.00 BY MYSELF. SOUTH TO THE SECTION CORNER: 2625.08 BY ALBRIGHT, 2624.88 BY HUGHES, 2624.76 BY DESINE AND 2625.11 BY MYSELF. FOUND TWO ACT 74'S RECORDED AND TWO ACT 132'S TO THIS CORNER. ONLY OBSTRUCTION FOR GPS IS THE OAK TREE AT N75W.

Charles E. Garlock

CHARLES E GARLOCK
PS 14762

K6MAR95

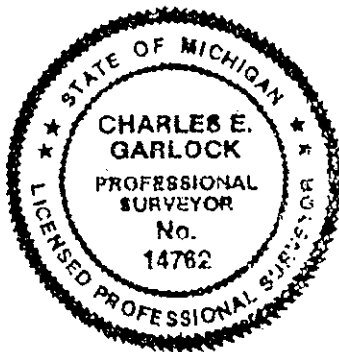

2N-4E
12-6

4