

Survey &
REMONUMENTATION

DEC 13 1993

COMMISSION

LAND CORNER RECORDATION CERTIFICATE
Filing Requirement of Act 74, Mich. P.A. 1970

For corners in

Livingston
(County)

Located In:

Corner Code #

- | | | |
|---------------------------------------|-------------------------|-------------|
| 1. Public Land Survey | T <u>2N</u> R <u>4E</u> | <u>K-11</u> |
| | T _____ R _____ | _____ |
| | T _____ R _____ | _____ |
| | T _____ R _____ | _____ |
| 2. Property Controlling in Section | S _____ T _____ R _____ | _____ |
| | S _____ T _____ R _____ | _____ |
| 3. Miscellaneous Property in Sec. | S _____ T _____ R _____ | _____ |
| | S _____ T _____ R _____ | _____ |
| 4. Lot No. _____, Recorded Plat _____ | | |
| 5. Private Claims _____ | | |

NOV 29 3 37 PM '93
 NANCY HAVILAND
 REGISTER OF DEEDS
 LIVINGSTON COUNTY, MI
 48843

FILED

L.S.C.#50m
Register of Deeds Stamp & File Number

	A	B	C	D	E	F	G	H	I	J	K	L	M
2	6		5		4		3		2		1		
3													
4	7		8		9		10		11		12		
5													
6	18		17		16		15		14		13		
7													
8	19		20		21		22		23		24		
9													
10	30		29		28		27		26		25		
11													
12	31		32		33		34		35		36		
13													

I, Darrell D Hughes, in a field survey on October 22, 1993, do hereby certify that under requirements of P.A. 74, Michigan P.A. of 1970, the corner points mentioned in lines 1 and 2 above were in conformance with regulations and rules therefore as required in the current manual of survey instructions of the United States Department of the Interior, Bureau of Land Management or by a decree of a Court of Law and/or that the corner points mentioned in lines 3, 4 and 5 above were in conformance with the rules of the Michigan Board of Land Surveyors or by a Decree of a Court of Law; established, re-established, monumented, re-monumented, recovered, found as expressed below:

NOTE: Not more than 4 corners, all in the same town and range, may be recorded on this certificate.

A. Description of original monument and accessories and/or subsequent restoration:

GLO survey notes: April 15, 1825
 GLO witnesses: B0 17-N55W-.74 ch
 B0 18-S40E-.44 ch

Additional historical data on rear of sheet:


B. Description of corner evidence found and/or method applied in restoring or reestablishing corner:

Found 1/2" I. Rod set by Boss Engr. about 1970

C. Description of monument for corner and accessories established to perpetuate locating the position of the corner:

K-11: NW cor. Sec. 36, T2N-R4E, re-set with 1 1/2" X 36" breakaway I. Pipe with Liv.Co. brass cap on top.
 N75W-14.60'-sp N/s 18" Cherry
 West-36.59'-sp S/s U. Pole
 East-24.08'-sp N/s 10" Cherry
 South-56.97'-NW corner Garage

Signed by Darrell D Hughes

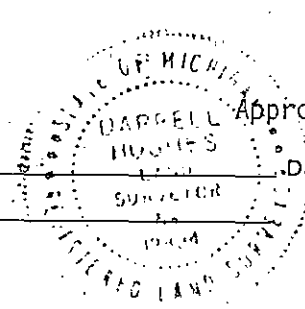

Approved by Liv. Co. Peer Group: Oct. 30, 1993
 Date 11-29-93

Surveyor's Michigan License No. 19834

October 23, 1993

K-11: NW Cor. Sec. 36 Marion Twp. Liv. Co. MI

Found $\frac{1}{2}$ " iron rod with Boss Engineering cap 354.29' East of spike in center-line of Pinckney Rd. and in East-West hedge-row with the remains of an old East-West fence on the ground. Found no occupation to North or South because land on either side of East-West line was owned by the same people for many years in Sections 25 and 26 North and Sections 35 and 36 South. Found no old County Surveyor witnesses in County Surveyor records. Earliest known reference to Corner was by L.W. Munsell in 1954 when he measured 356'± from the old center-line of Pinckney Rd. to a fence post. In 1961 when he returned to survey the reconstruction of Pinckney Rd. he measured 296.0' from the center-line of the road to a point called SE Corner Sec. 26, the same point shown on highway plans. A 1967 survey by L.W. Munsell also had 296.0' from the new center-line of Pinckney Rd. About 1970 a Boss Engineering survey called for the NW Corner to be 354.29' East of the center-line of Pinckney Rd. (new center-line: it was moved East in 1964 about 3-4 feet) where L.W. Munsell originally had 356'± from the old center-line of Pinckney Rd. in 1954. With the iron in the present location by Boss Engineering measures East are: 2613.57' to N 1/4 Cor. Sec. 36 and continuing 2621.63' to the NE Corner totaling 5235.20'. GLO notes call for 5240.4' and interpolation of old County Surveyor notes call for 2600.4' from NW Corner to N 1/4 Corner and continuing 2637.36' to the NE Corner totaling 5237.76'. Now going West into Section 35 the distance from the NW Corner Sec. 36 to N 1/4 Cor. Sec. 35 is 2587.18' and continuing to the NW Cor. Sec. 35 2590.4' totaling 5177.58'; GLO is 5175.72'. Therefore I recommend the present location for the NW Corner of Sec. 36 Marion Twp. Corner is in a hedge East and West, open to the North and buildings to the South.