

LAND CORNER RECORDATION CERTIFICATE
 Filing Requirement of Act 74, Mich. P.A. 1970

FILED

9

MAY 9 11 03 AM '95

NANCY HAVILAND
 REGISTER OF DEEDS
 LIVINGSTON COUNTY, MI
 48843

C.I.S.# 394m

Register of Deeds Stamp & File Number

For corners in

<u>Livingston</u> (County)	Located In:	Corner Code =#
1. Public Land Survey	T <u>2N</u> R <u>4E</u>	<u>L-3</u>
	T _____ R _____	_____
	T _____ R _____	_____
	T _____ R _____	_____
2. Property Controlling in Section	S _____ T _____ R _____	_____
	S _____ T _____ R _____	_____
3. Miscellaneous Property in Sec.	S _____ T _____ R _____	_____
	S _____ T _____ R _____	_____

4. Lot No. _____, Recorded Plat _____
 5. Private Claims _____

	A	B	C	D	E	F	G	H	I	J	K	L	M
2	6	5	4	3	2	1							
3													
4	7	8	9	10	11	12							
5													
6	18	17	16	15	14	13							
7													
8	19	20	21	22	23	24							
9													
10	30	29	28	27	26	25							
11													
12	31	32	33	34	35	36							
13													

Charles E Garlock, in a field survey on April 29, 19 95,
 do hereby certify that under requirements of P.A. 74, Michigan P.A. of 1970, the corner points mentioned
 in lines 1 and 2 above were in conformance with regulations and rules therefore as required in the
 current manual of survey instructions of the United States Department of the Interior, Bureau of Land
 Management or by a decree of a Court of Law and/or that the corner points mentioned in lines 3, 4 and 5
 above were in conformance with the rules of the Michigan Board of Land Surveyors or by a Decree of a
 Court of Law; established, re-established, monumented, re-monumented, recovered, found as
 expressed below:

NOTE: Not more than 4 corners, all in the same town and range, may be recorded
 on this certificate.


A. Description of original monument and accessories and/or subsequent restoration:
 GLO survey dated: April 15, 1825 by S Sibley DS
 GLO witnesses: B010-N86W-196 lks
 B016-S57E-336 lks

Additional historical survey data on rear of sheet

B. Description of corner evidence found and/or method applied in restoring or reestablishing corner:
 Found 1/2" I. rod one ft. South of c/l Francis Rd. and inline with old fence to the South

**SURVEY &
 REMONUMENTATION**
 OCT 6 1995
 COMMISSION

C. Description of monument for corner and accessories established to perpetuate locating the position of the corner:
 L-3: North 1/4 corner Section 12, T2N-R4E, Marion Twp. Liv. Co. MI; reset 1/2" I. Rod with
 1 1/4" X 36" breakaway I. Pipe with Liv. Co. Remon. brass cap on top at -0.5'
 S5E-24.98'-sp & tag E/s 18" locust
 S50W-58.23'-sp & tag N/s 12" locust
 N5W-28.84'-sp & tag E/s 36" maple
 N50E-56.85'-sp & tag S/s 30" W Cherry
 N65E-132.50'-sp & tag S/s U. Pole
 North-1'±-c/l of Francis Rd.

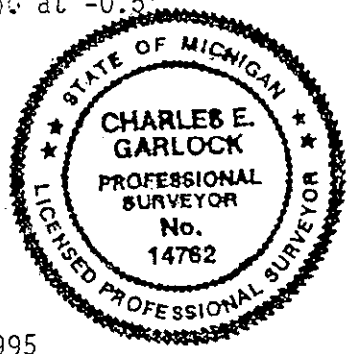

igned by Charles E. Garlock Date April 29, 1995
 urveyor's Michigan License No. 14762


CORNER SUMMARY

L-3: N 1/4 CORNER SECTION 12, T2N-R4E, MARION TWP. LIV. CO. MI
GLO SURVEY DATED APRIL 15, 1825 BY S SIBLEY AND NONE OF THE GLO
WITNESSES REMAIN.

OLD COUNTY SURVEYOR RECORDS INDICATE THE DISTANCE FROM NE COR. TO
THE N 1/4 COR. MAYBE 2603.37 FT. IN 1970 PL BENTON SET A 1/2" I
ROD ON THE CENTERLINE OF FRANCIS ROAD AND INLINE WITH AN OLD FENCE
LINE TO THE SOUTH AT 2602.26 FEET FROM THE NE SEC. CORNER.
WITNESSES TO THE NOW FOUND 1/2" I. ROD BY BENTON, BOSS, BRADY AND
MYSELF ALL CHECK TO SAID IRON. MEASURE WEST TO THE NW COR.
ARE: 2593.43 FT. BY BOSS AND BRADY AND 2593.20 BY BENTON. SOUTH TO
THE CENTER OF SECTION: 2645.34 FT. BY BOSS AND 2645.23 BY MYSELF.
FOUND ONE ACT 74 RECORDED AND NINE ACT 132'S. IRON IS IN A GRAVEL
ROAD AND AREA HAS OVER HANGING TREES 360 DEG.



CHARLES E GARLOCK
PS 14762

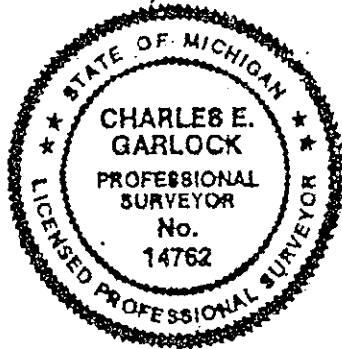

L3MAR95

TN-R4E
L3

4