

FILED

9

LAND CORNER RECORDATION CERTIFICATE
Filing Requirement of Act 74, Mich. P.A. 1970

MAY 9 11 03 AM '95

RANCY HAVILAND
REGISTER OF DEEDS
LIVINGSTON COUNTY, MI
48843

C.L.S.#395m

Register of Deeds Stamp & File Number

For corners in

Livingston

(County)

Located in:

Corner Code #

1. Public Land Survey

T 2N R 4E

L-5

T _____ R _____

T _____ R _____

T _____ R _____

2. Property Controlling
in Section

S _____ T _____ R _____

S _____ T _____ R _____

3. Miscellaneous

S _____ T _____ R _____

Property in Sec.

S _____ T _____ R _____

4. Lot No. _____, Recorded Plat _____

5. Private Claims _____

	A	B	C	D	E	F	G	H	I	J	K	L	M
2	6	5	4	3	2	1							
3													
4	7	8	9	10	11	12							
5													
6	18	17	16	15	14	13							
7													
8	19	20	21	22	23	24							
9													
10	30	29	28	27	26	25							
11													
12	31	32	33	34	35	36							
13													

Charles E Garlock, in a field survey on April 29, 19 95

do hereby certify that under requirements of P.A. 74, Michigan P.A. of 1970, the corner points mentioned in lines 1 and 2 above were in conformance with regulations and rules therefore as required in the current manual of survey instructions of the United States Department of the Interior, Bureau of Land Management or by a decree of a Court of Law and/or that the corner points mentioned in lines 3, 4 and 5 above were in conformance with the rules of the Michigan Board of Land Surveyors or by a Decree of a Court of Law; established, re-established, monumented, re-monumented, recovered, found as expressed below:

NOTE: Not more than 4 corners, all in the same town and range, may be recorded on this certificate.

Description of original monument and accessories and/or subsequent restoration:

GLO survey dated: April 15, 1825 by S sibley DS

Glo witnessess: B025-S41E-38 lks

W011-N4E-98 lks

Additional historical data on rear of sheet

Description of corner evidence found and/or method applied in restoring or reestablishing corner:
Found 1/2" I. Rod in c/l of Wright Rd and inline with old fence to South

SURVEY &
REMONUMENTATION

MAY 9 11 03 1995

COUNTY

Description of monument for corner and accessories established to perpetuate locating the position of the corner:

-5: North 1/4 corner Section 13, T2N-R4E, Marion Twp. Liv. Co. MI; reset 1/2" I. Rod with 1 1/4" X 36" breakaway I. Pipe with Liv. Co. Remon brass cap on top

S75E-85.35'-sp & tag North/s 40" Oak


N30E-33.19'-sp & tag S/s 38" Oak

N75W-54.85'-sp & tag-S/s 44" Oak

S75W-72.38'-sp & tag N/s 40" Oak

S20W-99.25'-NE cor. House Foundation Hse #580

On c/l of Wright Road

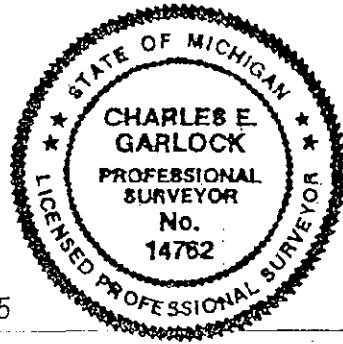

Witnessed by Charles E. Garlock

Date April 29, 1995

Surveyor's Michigan License No. 14762

FORM APPROVED BY MICHIGAN STATE BOARD OF LAND SURVEYORS, JAN. 28, 1971
PA. 345 1980, APPROVED BY LIVINGSTON COUNTY

REVISIED MAY 14, 1975
REVISIED JAN., 1983

DEED GROUP ON 3-1-95

CORNER SUMMARY


L-5: S 1/4 COR. OF SEC. 12, T2N-R4E, MARION TWP. LIV. CO., MI

GLO SURVEY DATED APRIL 15, 1825 BY S SIBLEY AND NONE OF THE GLO WITNESSES REMAIN.

M BULLOCK IN 1910 WITNESSED SAID CORNER, WITNESS IS GONE AND IN 1919 DUNNING DUG UP THIS CORNER BUT DID NOT WITNESS IT. IN 1961 L MUNSELL SET A 1/2" I. ROD IN LINE WITH THE FENCES NORTH & SOUTH, ON THE SPLIT OF THE ROAD SIDE FENCES AND SAID POINT FELL ON THE CENTERLINE OF WRIGHT ROAD (GRAVEL). SINCE THEN BENTON, BOSS, DESINE AND MYSELF HAVE USED THE SAME CORNER AND ALL WITNESSES THAT REMAIN CHECK TO THE PRESENT FOUND 1/2" I. ROD, INCLUDING ONE DATING TO 1961. MEASURES WEST TO THE SW SEC. CORNER ARE: 2518.90 BY NEWMAN & HUGHES, 2518.30 BY MUNSELL, 2518.43 BY DESINE, 2518.56 BY BOSS AND 2518.63 BY MYSELF. MEASURES EAST TO THE SE SEC. CORNER ARE: 2519.14 BY BOSS AND 2519.11 BY DESINE. MEASURES NORTH TO THE CTR. OF SEC. BY BOSS IS 2646.90 AND SOUTH TO THE CENTER OF SEC. 13 BY DESINE IS 2629.09. NO ACT 74 HAS BEEN RECORDED AND THREE ACT 132'S ARE RECORDED. POOR GPS STATION DUE TO THE OVER HANGING TREES.



CHARLES E GARLOCK
PS 14762

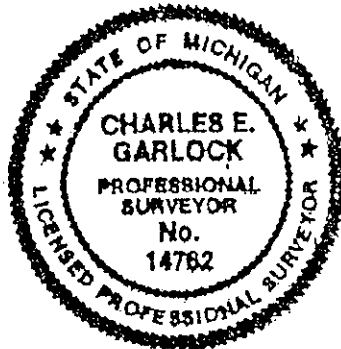

L5MAR95

2N4E

L5

2