

LAND CORNER RECORDATION CERTIFICATE
Filing Requirement of Act 74, Mich. P.A. 1970

For corners in

Livingston
(County)

Located In:

Corner Code #/

- | | | |
|------------------------------------|-------------------------|-----------|
| 1. Public Land Survey | T <u>2N</u> R <u>4E</u> | <u>M2</u> |
| | T _____ R _____ | _____ |
| | T _____ R _____ | _____ |
| | T _____ R _____ | _____ |
| 2. Property Controlling in Section | S _____ T _____ R _____ | _____ |
| | S _____ T _____ R _____ | _____ |
| 3. Miscellaneous Property in Sec. | S _____ T _____ R _____ | _____ |
| | S _____ T _____ R _____ | _____ |

FILED
MAY 20 11 03 AM '96
 NANCY HAVILAND
 REGISTER OF DEEDS
 LIVINGSTON COUNTY, MI
 48843
 L. S. C#529m
 Register of Deeds Stamp & File Number

4. Lot No. _____, Recorded Plat _____
 5. Private Claims _____

A	B	C	D	E	F	G	H	I	J	K	L	M
2	6	5	4	3	2							
3												
4	7	8	9	10	11	12						
5												
6	18	17	16	15	14	13						
7												
8	19	20	21	22	23	24						
9												
10	30	29	28	27	26	25						
11												
12	31	32	33	34	35	36						
13												

I, Charles E Garlock, in a field survey on May 20, 1996, do hereby certify that under requirements of P.A. 74, Michigan P.A. of 1970, the corner points mentioned in lines 1 and 2 above were in conformance with regulations and rules therefore as required in the current manual of survey instructions of the United States Department of the Interior, Bureau of Land Management or by a decree of a Court of Law and/or that the corner points mentioned in lines 3, 4 and 5 above were in conformance with the rules of the Michigan Board of Land Surveyors or by a Decree of a Court of Law; established, re-established, monumented, re-monumented, recovered, found as expressed below:


NOTE: Not more than 4 corners, all in the same town and range, may be recorded on this certificate.

- A. Description of original monument and accessories and/or subsequent restoration:
 GLO survey dated: April 15, 1825 by S Sibley, DS
 GLO witnesses: B06-N68W-36 lks
 W036-S7W-102 lks

**SURVEY &
 REMONUMENTATION**
 AUG 06 1996
 COMMISSION

Additional historical data on rear of sheet

- B. Description of corner evidence found and/or method applied in restoring or reestablishing corner:
 Found 1 1/4" X 48" I. Pipe set by A Pierson in 1965, MDOT

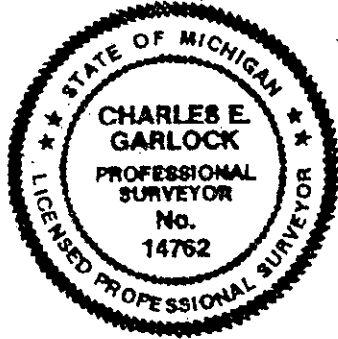

P.A. 345 1980, APPROVED BY LIVINGSTON COUNTY
PEER GROUP ON 2-7-96, CO. REP JED

- C. Description of monument for corner and accessories established to perpetuate locating the position of the corner:
 M-1 E 1/4 cor. Sec. 1 T2N-R4E, Marion Twp. Liv. Co. MI, set Liv. Co. Remon cap on top of found I. Pipe at -0.8'
 S35E-35.70'-sp & tag SW/s U Pole
 N60e-25.28'-sp & tag N/s U Pole
 S35W-40.20'-sp & tag E/s 40" Maple
 S88W-38.99'-Face 4" dia Steel post
 N65W-43.00'-Face 4" dia Steel post
 East-3.0'±- c/l Lucy Road
 North-446.92' along East Section line and West 0.65' to W 1/4 cor. Sec. 6 T2N-R5E Genoa Twp. Liv. Co. MI and North 3533.08' to NE cor. Sec. 1 Marion Twp. Liv. Co. MI


Signed by Charles E Garlock Date May 20, 1996
 Surveyor's Michigan License No. 14762

CORNER SUMMARY

M-2: EAST 1/4 CORNER OF SECTION 1, T2N-R4E, MARION TOWNSHIP,
LIVINGSTON COUNTY, MICHIGAN.

GLO SURVEY DATED APRIL 15, 1825 BY S SIBLEY, DS, AND NONE OF THE
GLO WITNESSES REMAIN.

MW BULLOCK IN 1893 WITNESSED A 12" MAPLE-WEST-20.46 FT. AND I
WITNESSED A 28" MAPLE-S85W-20.95 FT IN 1972 AND RECORDED AN ACT
74. A PIERSON, MDOT, IN 1965 SET A 1 1/4" X 48" I. PIPE FOR THE
CORNER FROM OLDER WITNESSES. ABOUT 1935 C GORDON FOUND THE
TOWNSHIP JOG NORTH TO THE WEST 1/4 CORNER OF SECTION 6, GENOA TWP.
TO BE 446.6 FT. AND WE MEASURED 446.92 FT. NORTH AND 0.65 FT. WEST
OF THE TOWNSHIP LINE TO A FOUND IRON FOR SAID WEST 1/4 CORNER.
ALL REMAINING WITNESSES BY PAST SURVEYORS CHECK WITH THE FOUND 1
1/4" I. PIPE. MEASURES NORTH TO THE TOWNSHIP CORNER ARE: 3538.2
FT. BY GORDON, 3532.16 BY GARLOCK, 3533.06 FT. BY BENTON AND
3533.08 FT. BY MYSELF IN 1996. MEASURES SOUTH TO THE SOUTHEAST
CORNER OF SECTION 1 ARE: 2593.35 FT. BY BOSS, 2593.25 FT. BY
BENTON, 2593.25 FT. BY GARLOCK, 2593.25 FT. BY MDOT AND 2559.1 FT.
BY GORDON. TREES LINE THE ROAD ON THE WEST SIDE AND A POWER LINE
ON THE EAST SIDE, SITE MAYNOT BE SUITABLE FOR GPS. CONSTRUCTION
OF LUCY ROAD IS GRAVEL. FOUND NO OTHER IRONS IN THE AREA AND THE
OLD OCCUPATION LINE TO THE WEST IS NOW GONE. RECOMMEND SETTING A
LIVINGSTON COUNTY REMON. BRASS CAP ON TOP OF THE FOUND IRON PIPE.

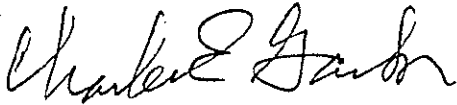

CHARLES E GARLOCK
PS 14762
MAR96M2

2N4E
114
4