

FILED

9'

LAND CORNER RECORDATION CERTIFICATE

Filing Requirement of Act 74, Mich. P.A. 1970

MAY 9 11 03 AM '95

NANCY HAVILAND
REGISTER OF DEEDS
LIVINGSTON COUNTY, MI
48843

C.L.S.#397m

Register of Deeds Stamp & File Number

For corners in

Livingston

(County)

Located In:

Corner Code #

1. Public Land Survey

T 2N R 4E

M-4

T R

T R

T R

2. Property Controlling
in Section

S T R

S T R

3. Miscellaneous
Property in Sec.

S T R

S T R

4. Lot No. , Recorded Plat

5. Private Claims

	A	B	C	D	E	F	G	H	I	J	K	L	M
2	6	5	4	3	2								
3													
4	7	8	9	10	11	12							
5													
6	16	17	16	15	14	13							
7													
8	19	20	21	22	23	24							
9													
10	30	29	28	27	26	25							
11													
12	31	32	33	34	35	36							
13													

Charles E Garlock, in a field survey on April 28, 1995

do hereby certify that under requirements of P.A. 74, Michigan P.A. of 1970, the corner points mentioned in lines 1 and 2 above were in conformance with regulations and rules therefore as required in the current manual of survey instructions of the United States Department of the Interior, Bureau of Land Management or by a decree of a Court of Law and/or that the corner points mentioned in lines 3, 4 and 5 above were in conformance with the rules of the Michigan Board of Land Surveyors or by a Decree of a Court of Law; established, re-established, monumented, re-monumented, recovered, found as expressed below:

NOTE: Not more than 4 corners, all in the same town and range, may be recorded on this certificate.

A. Description of original monument and accessories and/or subsequent restoration:

GLO survey dated: April 15, 1825 by S Sibley DS

GLO witnesses: W012-S57 1/2 W-120 lks

W012-S84 W-146 lks

Additional historical survey data on rear of sheet

B. Description of corner evidence found and/or method applied in restoring or reestablishing corner:

Found 1/2" I. Rod with occupation hedge row to the West, old fence line now gone.

CHARLES E. GARLOCK
REGISTER OF DEEDS

MAY 9 1995

COMMISSION

C. Description of monument for corner and accessories established to perpetuate locating the position of the corner:

M-4: East 1/4 corner Section 12, T2N-R4E, Marion Twp. Liv. Co. MI; reset 1/2" I. Rod with 1 1/4" X 36" breakaway I. Pipe with Liv. Co. Remon. brass cap on top.

S45E-36.35'-sp & tag NE/s U. Pole

S45W-34.71'-sp & tag E/s 40" oak


S55W-26.98'-sp & tag E/s 15" oak

N10W-139.69'-sp & tag E/s 36" Oak

N45W-116.40'-SE cor. Brick garage

East-1.5'-c/1 Fisk Rd.

North-435.1'-W 1/4 cor. Sec. 7 T2N-R5E

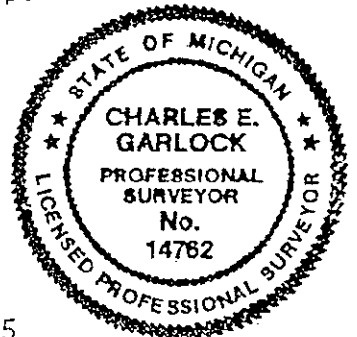

Signed by [Signature]

Date April 29, 1995

Surveyor's Michigan License No. 14762

CORNER SUMMARY

M-4: E 1/4 COR. SECTION 12, T2N-R4E, MARION TWP. LIV. CO. MI


GLO SURVEY DATED APRIL 15, 1825 BY S SIBLEY, NONE OF THE GLO WITNESSES REMAIN.

NEXT KNOWN ACTIVITY WAS 1961 WHEN L MUNSELL MAY HAVE FOUND OR SET A 1/2" I. ROD NEAR THE CENTERLINE OF A N.-S. GRAVEL ROAD AND INLINE WITH A HEDGE ROW AND REMAINS OF A FENCE (NOW GONE) TO THE WEST. WITNESSES BY BENTON, BOSS AND MYSELF CHECK WITH THE NOW FOUND 1/2" I. ROD. GLO DISTANCE NORTH TO THE GENOA TWP. 1/4 CORNER IS 377.52 FT. AND MEASURES 435.10. MEASURES NORTH TO THE NE SECTION CORNER ARE: 2705.56 FT. BY BOSS AND 2705.43 BY MYSELF. SOUTH TO THE SE SECTION COR.: 2657.40 FT. BY BENTON AND MYSELF AND 2657.41 BY BOSS. WEST TO THE CENTER OF SECTION: 2530.51 FT AND 2530.20 FT. BY BOSS. TWO ACT 74'S ARE RECORDED AND THREE ACT 132'S. AREA IS OPEN ONLY TO THE NW FOR A GPS STATION.

Charles E. Garlock

CHARLES E GARLOCK
PS 14762

M4MAR95

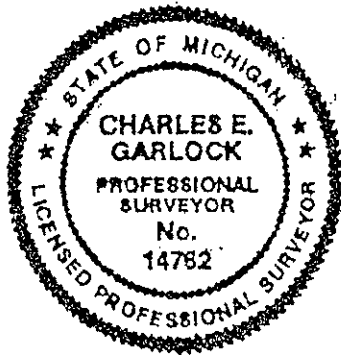

2N-4E 1M9

D