

FILED

LAND CORNER RECORDATION CERTIFICATE
Filing Requirement of Act 74, Mich. P.A. 1970

AUG 8 12 56 PM '94

For corners in

Livingston
(County)

Located In:

Corner Code M-7

NANCY HAVILAND
REGISTER OF DEEDS
LIVINGSTON COUNTY, MI
48843

- 1. Public Land Survey T 2N R 4E M-7
T _____ R _____
T _____ R _____
T _____ R _____
- 2. Property Controlling S _____ T _____ R _____
in Section S _____ T _____ R _____
- 3. Miscellaneous S _____ T _____ R _____
Property in Sec. S _____ T _____ R _____

L.S.C. #203A

Register of Deeds Stamp & File Number

- 4. Lot No. _____, Recorded Plat _____
- 5. Private Claims _____

	A	B	C	D	E	F	G	H	I	J	K	L	M
2	6		5		4		3		2		1		
3													
4	7		8		9		10		11		12		
5													
6	18		17		16		15		14		13		
7													
8	19		20		21		22		23		24		
9													
10	30		29		28		27		26		25		
11													
12	31		32		33		34		35		36		
13													

I, Charles E Garlock, in a field survey on June 7, 19 94

do hereby certify that under requirements of P.A. 74, Michigan P.A. of 1970, the corner points mentioned in lines 1 and 2 above were in conformance with regulations and rules therefore as required in the current manual of survey instructions of the United States Department of the Interior, Bureau of Land Management or by a decree of a Court of Law and/or that the corner points mentioned in lines 3, 4 and 5 above were in conformance with the rules of the Michigan Board of Land Surveyors or by a Decree of a Court of Law; established, re-established, monumented, re-monumented, recovered, found as expressed below:


NOTE: Not more than 4 corners, all in the same town and range, may be recorded on this certificate.

- A. Description of original monument and accessories and/or subsequent restoration:
GLO survey date: April 15, 1825 by S Sibley
GLO witness: W011-S18W-2.25 ch
B012-S60W-3.54 ch

- See additional data on rear of sheet
- B. Description of corner evidence found and/or method applied in restoring or reestablishing corner:
Found Concrete monument with 1/2" I. rod at NE corner of DAVIS ROAD ESTATES NO. 1
Liber 13 Plats, pages 1 and 2 Liv.Co.Rec.

SURVEY &
REMONUMENTATION
SEP 26 1994
COMMISSION

- D. Description of monument for corner and accessories established to perpetuate locating the position of the corner:
M-7, NE cor. Sec. 24 Marion Twp. T2N-R4E, Liv. Co. MI.
Set Liv. Co. Remon. cap on top of found concrete monument.
South-19.41'-sp & tag E/s 16" W Oak
S45E-19.88'-sp & tag S/s 15" W Oak
N35E-46.81'-sp & tag W/s 36" W Oak
N75W-114.91'-sp & tag S/s U Pole
N45W-20'±- ctr. of Road
Ctr. of Road to West and North and Old hedge row to the South

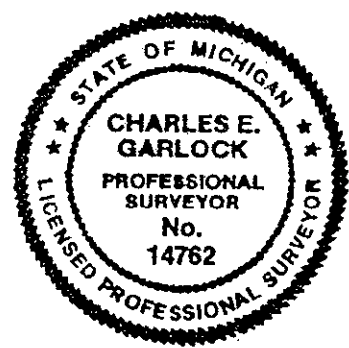

Signed by Charles E. Garlock


Date August 1, 1994

Surveyor's Michigan License No. 14762

CORNER SUMMARY

M-7 NE Cor. Sec.24, Marion Twp., Livingston Co., MI

GLO notes dated April 15, 1825 by S. Sibley, D.S.
 Earliest known witness is 1910 by M.W. Bullock, but witness tree is gone now and not mentioned in any witnesses since 1967. In 1967 I set a concrete monument in place of a found 1/2" Iron Rod for the NE Corner, at the time of platting "Davis Road Estates". Since that time the following surveyors have used the concrete monument: J. Albright, Boss Engineering, Desine, B.F. Thompson and myself. Measures to the West to the N 1/4 Corner are 2533.64' = Garlock, 2533.84 = Albright, and 2533.46 = Desine. To the South to the E 1/4 Corner: 2634.35' = Garlock and 2634.33 = Boss Engineering. The NW Corner of Sec.19 Genoa Twp. is located 279.18' Northerly and GLO calls for a 282.48' jog. The Corner is located near the P.I. of Davis and Fisk Rds. (gravel) with trees lining the road North on the East side and South along the hedge row. This corner lines with centerline of Road to the North and to the West, it also lines with an old fence line to the South.
 Found no other irons in the area.

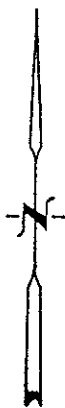

Charles E. Garlock

