

SURVEY & REMONUMENTATION

OCT 21 1999

SECTION

LAND CORNER RECORDATION CERTIFICATE  
Filing Requirement of Act 74, Mich. P.A. 1970

AUG 8 12 56 PM '94

NANGY HAVILAND  
REGISTER OF DEEDS  
LIVINGSTON COUNTY, MI  
48843

For corners in

Livingston  
(County)

Located In:

Corner Code #

- 1. Public Land Survey T2N R 4E M-9  
T R  
T R  
T R
- 2. Property Controlling S T R  
in Section S T R
- 3. Miscellaneous S T R  
Property in Sec. S T R
- 4. Lot No. , Recorded Plat
- 5. Private Claims

L.S.C. #204m

Register of Deeds Stamp & File Number

I, Charles E Garlock in a field survey on June 7, 19 94, do hereby certify that under requirements of P.A. 74, Michigan P.A. of 1970, the corner points mentioned in lines 1 and 2 above were in conformance with regulations and rules therefore as required in the current manual of survey instructions of the United States Department of the Interior, Bureau of Land Management or by a decree of a Court of Law and/or that the corner points mentioned in lines 3, 4 and 5 above were in conformance with the rules of the Michigan Board of Land Surveyors or by a Decree of a Court of Law; established, re-established, monumented, re-monumented, recovered, found as expressed below:

**NOTE: Not more than 4 corners, all in the same town and range, may be recorded on this certificate.**

	A	B	C	D	E	F	G	H	I	J	K	L	M
2	6		5		4		3		2		1		
3													
4	7		8		9		10		11		12		
5													
6	18		17		16		15		14		13		
7													
8	19		20		21		22		23		24		
9													
10	30		29		28		27		26		25		
11													
12	31		32		33		34		35		36		
13													

A. Description of original monument and accessories and/or subsequent restoration:

GLO survey date: April 15, 1825 by S Sibley  
GLO witnessess: W011-S19W-0.29 ch  
W012-N36W-0.95 ch


See additional data on rear of sheet

B. Description of corner evidence found and/or method applied in restoring or reestablishing corner:

Found 1/2" I. rod at -1.0'±

C. Description of monument for corner and accessories established to perpetuate locating the position of the corner:

M-9, SE corner Section 24, T2N-R4E, Marion Twp. Liv. Co. MI.  
Replaced found 1/2" I. Rod with 1 1/4" X 36" I. Pipe with Liv. Co. Remon brass cap at -1.0'  
North-21.16'-sp & tag W/s 28" Maple  
South-125.85'-sp & tag E/s U. Pole  
S15E-133.40'-sp & tag W/s U. Pole  
S45E-104.64'-sp & tag E/s 34" Walnut  
South-19.2'-ctr. Coon Lake Rd. running E. & W.

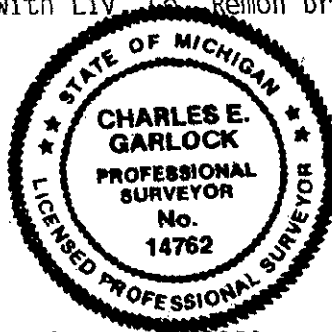

Signed by

*Charles E. Garlock*

Date August 1, 1994

Surveyor's Michigan License No.

14762

FILED

CORNER SUMMARY


NE 1/4 NE 1/4 Sec. 25, Marion Twp., Livingston Co., MI

GLO dated April 15, 1825 by S. Sibley, D.S.  
 Earliest known witness by Co. Surveyors was 1904 by M.W. Bullock and in 1917 G.H. Dunning found a 3/8" Iron Rod and measured same distance as Bullock to the witness tree. Next recovery date was 1957 by L.W. Munsell who also found a 3/8" Iron Rod, but none of his witnesses remained when P.L. Benton found an Iron Rod in 1977 as did Boss Engineering in 1979. But a distance from the NE Corner of Sec. 25, West to what was called the NW Corner E 1/2 NE 1/4 Sec. 25 (POB of "Highland Beach Sub.") by L.W. Munsell in 1957 nearby matched that of Boss Engineering in 1979. I found an Iron Rod, 1/2"±, from witnesses by Benton and Boss Engineering and this Iron Rod was about 20'± North of the existing centerline of Coon Lake Rd. as per L.W. Munsell. Also found good occupation North and South along the Township line. Not so with Coon Lake Rd. because it wanders back and forth around terrain features from Marion to Genoa Twps. Iron is located below North shoulder of road and fairly open in all directions except NE. Measures from the NE corner of Section 25 are as follows: N0-56-23W 2658.78 feet to the E 1/4 corner Section 24, S1-00-15E 2645.17 feet to the E 1/4 corner of Section 25 and S87-56-03W 2613.74 feet to the N 1/4 corner of Section 25.  
 Found no other irons in the area.

SURVEY & REMONUMENTATION

OCT 21 1999

SECTION

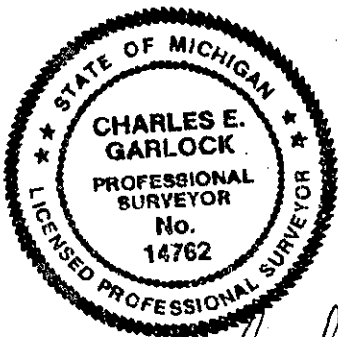

*Charles E. Garlock*  
 36

