

SURVEY & REMONUMENTATION

9

DEC 13 1993

LAND CORNER RECORDATION CERTIFICATE
Filing Requirement of Act 74, Mich. P.A. 1970

For corners in COMMISSION
Livingston
(County)

Located In: _____ Corner Code #/

- | | | |
|------------------------------------|-------------------------|-------------|
| 1. Public Land Survey | T <u>2N</u> R <u>5E</u> | <u>A-13</u> |
| | T _____ R _____ | _____ |
| | T _____ R _____ | _____ |
| | T _____ R _____ | _____ |
| 2. Property Controlling in Section | S _____ T _____ R _____ | _____ |
| | S _____ T _____ R _____ | _____ |
| 3. Miscellaneous Property in Sec. | S _____ T _____ R _____ | _____ |
| | S _____ T _____ R _____ | _____ |

NOV 29 3 37 PM '93
 NANCY HAYLAND
 REGISTER OF DEEDS
 LIVINGSTON COUNTY, MI
 48843
 REGISTERED
 FILED
 L.S.C. #57m
 Register of Deeds Stamp & File Number

4. Lot No. _____, Recorded Plat _____
5. Private Claims _____

I, Darrell D Hughes, in a field survey, on October 22, 19 1993, do hereby certify that under requirements of P.A. 74, Michigan P.A. of 1970, the corner points mentioned in lines 1 and 2 above were in conformance with regulations and rules therefore as required in the current manual of survey instructions of the United States Department of the Interior, Bureau of Land Management or by a decree of a Court of Law and/or that the corner points mentioned in lines 3, 4 and 5 above were in conformance with the rules of the Michigan Board of Land Surveyors or by a Decree of a Court of Law; established, re-established, monumented, re-monumented, recovered, found as expressed below:

| A | B | C | D | E | F | G | H | I | J | K | L | M |
|----|----|----|----|----|----|----|---|---|---|---|---|---|
| 2 | 6 | 5 | 4 | 3 | 2 | 1 | | | | | | |
| 3 | | | | | | | | | | | | |
| 4 | 7 | 8 | 9 | 10 | 11 | 12 | | | | | | |
| 5 | | | | | | | | | | | | |
| 6 | 18 | 17 | 16 | 15 | 14 | 13 | | | | | | |
| 7 | | | | | | | | | | | | |
| 8 | 19 | 20 | 21 | 22 | 23 | 24 | | | | | | |
| 9 | | | | | | | | | | | | |
| 10 | 30 | 29 | 28 | 27 | 26 | 25 | | | | | | |
| 11 | | | | | | | | | | | | |
| 12 | 31 | 32 | 33 | 34 | 35 | 36 | | | | | | |
| 13 | | | | | | | | | | | | |

NOTE: Not more than 4 corners, all in the same town and range, may be recorded on this certificate.


- A. Description of original monument and accessories and/or subsequent restoration:
 GLO survey notes: May 14, 1823
 GLO witnesses: B0 16-S81W-.72 ch
W0 12-S16E-.26 ch.

Additional historical data on rear of sheet:

- B. Description of corner evidence found and/or method applied in restoring or reestablishing corner:
 Found $\frac{1}{2}$ " I. Rod on North edge of gravel road.

- C. Description of monument for corner and accessories established to perpetuate locating the position of the corner:
 A-13: SW cor. Section 31, T2N-R5E, reset with $1\frac{1}{2}$ " X 36" I. Pipe with Liv. Co. brass cap on top.
 S81E-39.15'-sp S/s 12" oak
 S72E-58.62'-sp S/s 15" Oak
 S25E-79.12'-sp N/s 10" Pine
 S10W-40.73'-sp E/s 38" W Oak
 S5W-38.71'-1/2" I. Rod w/cap
 N52W-48.69'-ctr. 3" dia. Consumers Power Gas line marker

Signed by Darrell D Hughes
 Surveyor's Michigan License No: 19834

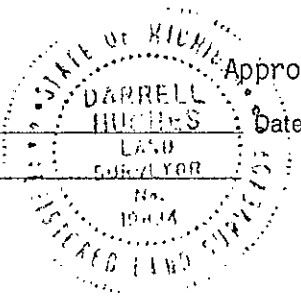

Approved by Liv. Co. Peer Group: Oct. 30, 1993
 Date 11-29-93

Found $\frac{1}{2}$ " iron rod at North edge of gravel road (bent Westerly). Earliest known witnesses by County surveyors, date unknown, but a previous witness of S2W-.61 lks. (40.26') 18" W.Oak also measures 40.26', but tree is about 34" now. All witnesses by Boss Engineering dated 1981, 1990 are to the found iron. All witnesses by Garlock dated 1969 and 1973 are to the found iron. Act 74's filed by both Boss Engineering 1992 and Garlock 1973. Gas line by Consumers Power may have removed previous witnesses Northeasterly and Southwesterly of Corner. Old occupation exists to North and South, center line of road to West and road angles Southeasterly to East around low areas. Surveys in Marion and Putnam Twp. are tied to this Corner as an old Co. Surveyor witness to NW Cor. Sec. 6 Hamburg Twp. Therefore I believe this to be a Corner common to four Townships. Sweep of the area found no additional irons. Woods found in NW and SW quadrants and several trees in NE and SE quadrants. Road surface is gravel.