

MAR 17 2000

FILED

SECTION

LAND CORNER RECORDATION CERTIFICATE  
Filing Requirement of Act 74, Mich. P.A. 1970

1999 NOV 22 A 11:07

For corners in  
LIVINGSTON  
(County)

Located in: GENOA Corner Code #

9

NANCY HAVILAND  
REGISTER OF DEEDS  
LIVINGSTON COUNTY, MI.  
48843

- 1. Public Land Survey T 2N R 5E C-9  
T \_\_\_\_\_ R \_\_\_\_\_  
T \_\_\_\_\_ R \_\_\_\_\_  
T \_\_\_\_\_ R \_\_\_\_\_
- 2. Property Controlling S \_\_\_\_\_ T \_\_\_\_\_ R \_\_\_\_\_  
in Section S \_\_\_\_\_ T \_\_\_\_\_ R \_\_\_\_\_
- 3. Miscellaneous S \_\_\_\_\_ T \_\_\_\_\_ R \_\_\_\_\_  
Property in Sec. S \_\_\_\_\_ T \_\_\_\_\_ R \_\_\_\_\_

ISC# 1098m

Register of Deeds Stamp and File Number

- 4. Lot No. \_\_\_\_\_, Recorded Plat \_\_\_\_\_
- 5. Private Claims \_\_\_\_\_

I, Bryan L. Boss, in a field survey on AUG. 31, 1999

do hereby certify that under requirements of P.A. 74, Michigan P.A. of 1970, the corner points mentioned in lines 1 and 2 above were in conformance with regulations and rules therefor as required in the current manual of survey instructions of the United States Department of the Interior, Bureau of Land Management or by a decree of a Court of Law and/or that the corner points mentioned in lines 3, 4 and 5 above were in conformance with the rules of the Michigan Board of Land Surveyors or by a Decree of a Court of Law; established, re-established, monumented, re-monumented, recovered, found as expressed below.

NOTE: Not more than 4 corners, all in the same town and range, may be recorded on this certificate.

	A	B	C	D	E	F	G	H	I	J	K	L	M
2	6		5		4		3		2		1		
3													
4	7		8		9		10		11		12		
5													
6	16		17		18		15		14		13		
7													
8	19		20		21		22		23		24		
9													
10	30		29		28		27		26		25		
11													
12	31		32		33		34		35		36		
13													

A. Description of original monument and accessories and/or subsequent restoration:


SET POST  
10" B. OAK S22°E 58 LINKS  
6" W. OAK N33°E 5 LINKS

B. Description of corner evidence found and/or method applied in restoring or reestablishing corner:

FOUND 1/2" IRON ROD IN CENTER LINE OF WESTPHAL RD, WITH  
FENCES RUNNING EAST AND WEST.

C. Description of monument for corner and accessories established to perpetuate locating the position of the corner:

SET 1 1/4" X 30" PIPE WITH PLASTIC  
INSERT CONNECTED TO A 1 1/4" X 6" PIPE WITH  
BRASS CAP STAMPED "LIVINGSTON COUNTY  
REMONUMENTATION CORNER  
DUE EAST 70.30' SET REMON N/T N/S 30" OAK  
S80°E 30.35' SET REMON N/T S/S 8" OAK  
S80°W 32.08' SET REMON N/T NW/S 8" OAK  
N45°W 39.78' SET REMON N/T NE/S 8" OAK

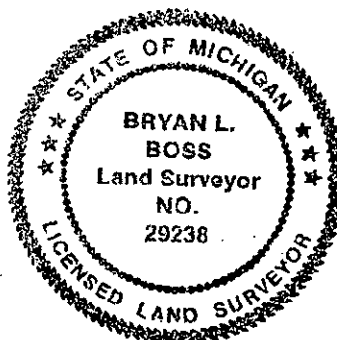

PA. 343 1999, APPROVED BY LIVINGSTON COUNTY  
PEER GROUP ON 5-19-99, CO. REP JED

Signed by [Signature]

Date NOV. 9, 1999

Surveyor's Michigan License No. 29238