

SURVEY & REMONUMENTATION

FEB 25 1999

SECTION

LAND CORNER RECORDATION CERTIFICATE
Filing Requirement of Act 74, Mich. P.A. 1970

FILED

For corners in

| <u>Livingston</u> <small>(County)</small> | Located In. | Corner Code // |
|--|-------------|----------------|
| 1. Public Land Survey | 1 2N R 5E | C-12 |
| | I R | |
| | T R | |
| | T R | |
| 2. Property Controlling in Section | S T R | |
| | S T R | |
| 3. Miscellaneous Property in Sec. | S T R | |
| | S T R | |

1998 OCT 22 P 1:18

NANCY HAVILAND
REGISTER OF DEEDS
LIVINGSTON COUNTY, MI.
48843

LSC953M

Register of Deeds Stamp & File Number

- 4. Lot No. _____, Recorded Plat _____
- 5. Private Claims _____

| | A | B | C | D | E | F | G | H | I | J | K | L | M |
|----|----|----|----|----|----|----|---|---|---|---|---|---|---|
| 2 | 6 | 5 | 4 | 3 | 2 | | | | | | | | |
| 3 | | | | | | | | | | | | | |
| 4 | 7 | 8 | 9 | 10 | 11 | 12 | | | | | | | |
| 5 | | | | | | | | | | | | | |
| 6 | 18 | 17 | 16 | 15 | 14 | 13 | | | | | | | |
| 7 | | | | | | | | | | | | | |
| 8 | 19 | 20 | 21 | 22 | 23 | 24 | | | | | | | |
| 9 | | | | | | | | | | | | | |
| 10 | 30 | 29 | 28 | 27 | 26 | 25 | | | | | | | |
| 11 | | | | | | | | | | | | | |
| 12 | 31 | 32 | 33 | 34 | 35 | 36 | | | | | | | |
| 13 | | | | | | | | | | | | | |

I, Bryan L. Boss, in a field survey on Oct. 2, 1998, do hereby certify that under requirements of P.A. 74, Michigan P.A. of 1970, the corner points mentioned in lines 1 and 2 above were in conformance with regulations and rules therefore as required in the current manual of survey instructions of the United States Department of the Interior, Bureau of Land Management or by a decree of a Court of Law and/or that the corner points mentioned in lines 3, 4 and 5 above were in conformance with the rules of the Michigan Board of Land Surveyors or by a Decree of a Court of Law; established, re-established, monumented, re-monumented, recovered, found as expressed below:

NOTE: Not more than 4 corners, all in the same town and range, may be recorded on this certificate.

A. Description of original monument and accessories and/or subsequent restoration:

Corner Set in 1823 by S. Sibley, Deputy Surveyor, Set Post
Tamarack 6" 71 E 20 links
Tamarack 6" 10 W 20 links

B. Description of corner evidence found and/or method applied in restoring or reestablishing corner:


FD pinched pipe @ Intersection of fence north/South/West in swamp and removed

PA. 345 1990, APPROVED BY LIVINGSTON COUNTY

PEER GROUP ON 9-2-98 CO. REP JED

C. Description of monument for corner and accessories established to perpetuate locating the position of the corner:

Set 36" long by 1 1/2" Steel Pipe
W/Brass Cap # 29238 Stamped "Livingston County Monumentation
Corner 42.48' JD
N 10 E (43.48) Remon N/T W side 10" Tamarack
Due East 23.41 Remon N/T S. Side 20" Maple
S. 40E 41.90 Remon N/T S.W. side 16" Maple
S 80 W 31.50 Remon N/T Side Multi-Stem Maple

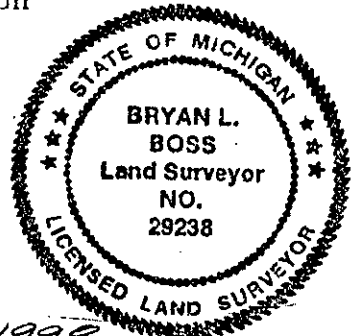

Signed by [Signature]

Date 10-14-1998

Surveyor's Michigan License No. 29238