

MAR 17 2000

SECTION

LAND CORNER RECORDATION CERTIFICATE
Filing Requirement of Act 74, Mich. P.A. 1970

1999 NOV 22 A 11: 07

For corners in
LIVINGSTON
(County)

Located in: GENOA Corner Code #

- 1. Public Land Survey T 2N R 5E E-10
T _____ R _____
T _____ R _____
T _____ R _____
- 2. Property Controlling S _____ T _____ R _____
in Section S _____ T _____ R _____
- 3. Miscellaneous S _____ T _____ R _____
Property in Sec. S _____ T _____ R _____
- 4. Lot No. _____, Recorded Plat _____
- 5. Private Claims _____

9

NANCY HAVILAND
REGISTER OF DEEDS
LIVINGSTON COUNTY, MI.
48843

LSC# 1102m
Register of Deeds Stamp and File Number

I, Bryan L. Boss, in a field survey on OCT. 15, 1999

do hereby certify that under requirements of P.A. 74, Michigan P.A. of 1970, the corner points mentioned in lines 1 and 2 above were in conformance with regulations and rules therefor as required in the current manual of survey instructions of the United States Department of the Interior, Bureau of Land Management or by a decree of a Court of Law and/or that the corner points mentioned in lines 3, 4 and 5 above were in conformance with the rules of the Michigan Board of Land Surveyors or by a Decree of a Court of Law; established, re-established, monumented, re-monumented, recovered, found as expressed below.

NOTE: Not more than 4 corners, all in the same town and range, may be recorded on this certificate.

A	B	C	D	E	F	G	H	I	J	K	L	M
2	6	5	4	3	2	1						
3												
4	7	8	9	10	11	12						
5												
6	18	17	16	15	14	13						
7												
8	19	20	21	22	23	24						
9												
10	30	29	28	27	26	25						
11												
12	31	32	33	34	35	36						
13												

A. Description of original monument and accessories and/or subsequent restoration:


- SET POST
- 8" TAMARACK N. 73 1/2° E 98L (64.68')
- 12" TAMARACK N. 31 1/2° W 86L (56.78')

B. Description of corner evidence found and/or method applied in restoring or reestablishing corner:

FOUND 1/2" IRON ROD

C. Description of monument for corner and accessories established to perpetuate locating the position of the corner:

- SET 1 1/4" X 3/8" PIPE WITH BRASS CAP STAMPED "LIVINGSTON COUNTY REMONUMENTATION CORNER"
- S40°E 41.18' SET REMON NAIL & TAG S/ S 10" TAMARACK
- S10°E 33.90' SET REMON NAIL & TAG E/S 10" TAMARACK
- S45°W 34.00' SET REMON NAIL & TAG E/S 5" TREE
- N80°W 17.40' SET REMON NAIL & TAG S/S 3" TREE

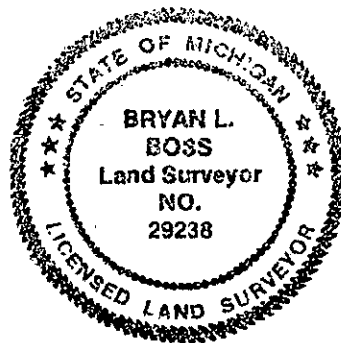

P.A. 345 100, APPROVED BY LIVINGSTON COUNTY
PEER GROSSMAN 6-16-99, CO. REP JED

Signed by Bryan L. Boss

Date NOV. 1, 1999

Surveyor's Michigan License No. 29238