

FEB 25 1999

SECTION

LAND CORNER RECORDATION CERTIFICATE
Filing Requirement of Act 74, Mich. P.A. 1970

9-
FILED

For corners in

Livingston
County

Located In.

Corner Code //

- 1. Public Land Survey T 2N R 5E E-12
- T R
- T R
- T R
- 2. Property Controlling S T R
- In Section S T R
- 3. Miscellaneous S T R
- Property in Sec. S T R

1998 OCT 22 P 1:18

NANCY HAVILAND
REGISTER OF DEEDS
LIVINGSTON COUNTY, MI.
48843

LSC956M

Register of Deeds Stamp & File Number

- 4. Lot No. _____, Recorded Plat _____
- 5. Private Claims _____

	A	B	C	D	E	F	G	H	I	J	K	L	M
2	6	5	4	3	2	1							
3													
4	7	8	9	10	11	12							
5													
6	18	17	16	15	14	13							
7													
8	19	20	21	22	23	24							
9													
10	30	29	28	27	26	25							
11													
12	31	32	33	34	35	36							
13													

I, Bryan L. Boss in a field survey on Oct. 2, 1998 do hereby certify that under requirements of P.A. 74, Michigan P.A. of 1970, the corner points mentioned in lines 1 and 2 above were in conformance with regulations and rules therefore as required in the current manual of survey instructions of the United States Department of the Interior, Bureau of Land Management or by a decree of a Court of Law and/or that the corner points mentioned in lines 3, 4 and 5 above were in conformance with the rules of the Michigan Board of Land Surveyors or by a Decree of a Court of Law; established, re-established, monumented, re-monumented, recovered, found as expressed below:

NOTE: Not more than 4 corners, all in the same town and range, may be recorded on this certificate.

A. Description of original monument and accessories and/or subsequent restoration:

Corner Set 1823 by S.Sibley Deputy Surveyor, Set Post
12" Black Oak S 35 E. 34 links
20" White Oak N. 78 W. 27 Links

B. Description of corner evidence found and/or method applied in restoring or reestablishing corner:


FD 1/2" I Rod 1' Deep in
Centerline King Road. Occupation West
is old fence line.

P.A. 345 1980, APPROVED BY LIVINGSTON COUNTY

PEER GROUP ON 9-2-98, CO. REP JED

C. Description of monument for corner and accessories established to perpetuate locating the position of the corner:

Set 30-long by 1 1/4" Steel pipe
with 6" long by 1 1/4" Steel
Break away W/Brass Cap # 29238 Stamped "Livingston County
Monumentation Corner"
(0.80 Deep)
N 20 E 95.17 FD Remon N/T W Side 12" Cherry
S 50 E 64.50' Fd Remon N/T M.E. Side P.pole
S 60 W 35.03 FD Remon N/T S.E.Side 10" Hickory
N 50 W 36.67 FD Remon N/T N.E. Side 10" Hickory
South of Centerline Richman Farms Drive
370'

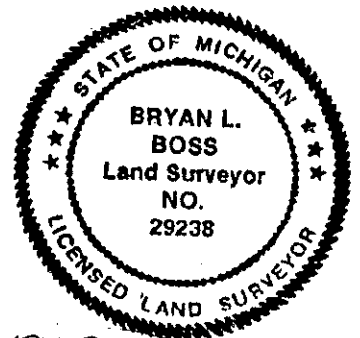

Signed by Bryan L. Boss

Date 10-14-1998

Surveyor's Michigan License No. 29238