

MAR 17 2000

SECTION

LAND CORNER RECORDATION CERTIFICATE
Filing Requirement of Act 74, Mich. P.A. 1970

1999 NOV 22 A 11: 07

For corners in

LIVINGSTON

(County)

Located in: GENOA

Corner Code #

9

NANCY HAVILAND
REGISTER OF DEEDS
LIVINGSTON COUNTY, MI.
48843

- 1. Public Land Survey T 2N R 5E G-9
T _____ R _____
T _____ R _____
T _____ R _____
- 2. Property Containing S _____ T _____ R _____
in Section S _____ T _____ R _____
- 3. Miscellaneous S _____ T _____ R _____
Property in Sec S _____ T _____ R _____

LSC# 1104m

Register of Deeds Stamp and File Number

- 4. Lot No. _____, Recorded Plat _____
- 5. Private Claims _____

I, Bryan L. Boss, in a field survey on AUG. 31, 1999

do hereby certify that under requirements of P.A. 74, Michigan P.A. of 1970, the corner points mentioned in lines 1 and 2 above were in conformance with regulations and rules therefor as required in the current manual of survey instructions of the United States Department of the Interior, Bureau of Land Management or by a decree of a Court of Law and/or that the corner points mentioned in lines 3, 4 and 5 above were in conformance with the rules of the Michigan Board of Land Surveyors or by a Decree of a Court of Law; established, re-established, monumented, re-monumented, recovered, found as expressed below.

NOTE: Not more than 4 corners, all in the same town and range, may be recorded on this certificate.

A. Description of original monument and accessories and/or subsequent restoration:

- SET POST IN LAKE 48 LINKS (31.68') FROM EAST SHORE
- 10" POPLAR STUMP 61 LINKS (40.26')
- 12" B. OAK S86°12'E 78 LINKS (51.48')

B. Description of corner evidence found and/or method applied in restoring or reestablishing corner:

- FOUND 1 1/2" IRON PIPE +/- 8' EAST OF EAST SHORE OF CROOKED LAKE AT THE SOUTHEAST CORNER OF LOT 62 AND NORTHWEST CORNER OF LOT 63 OF "CROOKED LAKE HIGHLANDS SUBDIVISION"


C. Description of monument for corner and accessories established to perpetuate locating the position of the corner:

- SET BRASS CAP STAMPED "LIVINGSTON COUNTY REMONUMENTATION CORNER" INSIDE EXISTING 1 1/2" PIPE.
- N70°E 2.13' SET REMON NAIL & TAG N/SIDE 20" STUMP
- N15°E 55.91' SET REMON NAIL & TAG E/SIDE TWIN 10" ELM
- S40°E 74.62' SET REMON NAIL & TAG SW/SIDE 24" OAK
- S03°W 54.00' SET REMON NAIL & TAG W/SIDE 18" OAK

	A	B	C	D	E	F	G	H	I	J	K	L	M
2	6	5	4	3	2	1							
3													
4	7	8	9	10	11	12							
5													
6	18	17	16	15	14	13							
7													
8	19	20	21	22	23	24							
9													
10	30	29	28	27	26	25							
11													
12	31	32	33	34	35	36							
13													

P.A. 340, 1990, APPROVED BY LIVINGSTON COUNTY

PEER GROUP ON 6-16-99 CO. REP JED

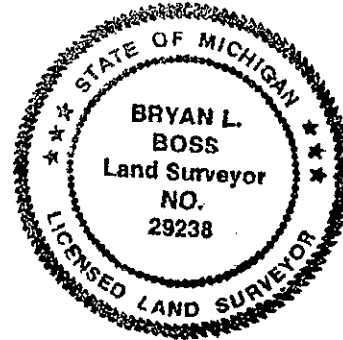

Signed by Bryan L. Boss

Date NOV. 9, 1999

Surveyor's Michigan License No. 29238